Marion


DX 78-1

KANSAS

Section 27 Township 18 Range 4E

Well No. #1 Musterman

Company W.H. Pitts

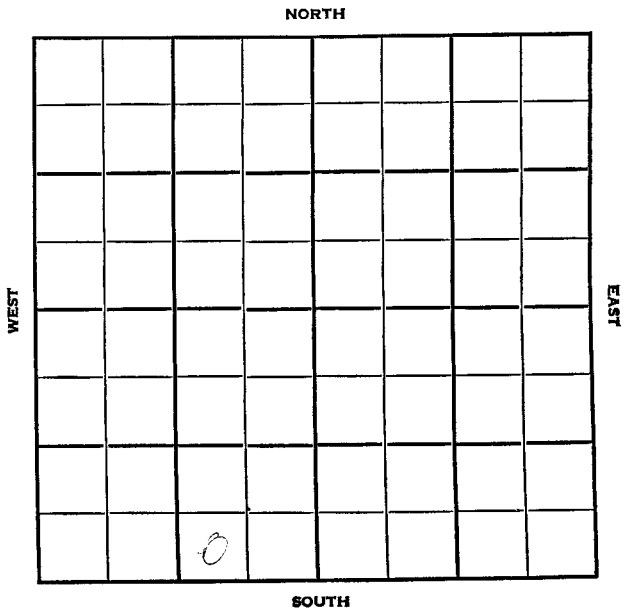

FORM 513 SUNRAY

County Marion Elev.

Sec. 27 Twp. 18 Rge. 4E

Company W. H. Pitts

Farm Name Mustermann No. 1

TOPS	DEPTH	LOG	DATUM
Anh.			
Tp.			
H.			
Tr.			
Dg.			
Bl.			
L.			
K.C.			
B.K.C.			
Ce.			
C.			
M.			
M.			
K.			
Mz.			
Mc.			
V.			
S.			
S.			
A			
R.			
Pc.			
G.			
TD			

Loc. in Sec. SW SE SW

Geol.

Contr. Sunflower

Pool

NOV 7 '56

FIRST REPORT

Co. Lse. No. Sec. T. R.

Date Comm. 11-2-56

8 5/8" @ 150 drlg. 1980

FORM S13 SUNRAY

County Marion Elev.

Sec. 27 Twp. 18 Rge. 1E

Company W. A. Pitts

Farm Name Musterman No. 1

TOPS	DEPTH	LOG	DATUM
Anhy.			
Tp.			
H.			
Tr.			
Dg.			
Bl.			
L.			
K.C.	1780		
B.K.C.			
Ce.			
C.			
M. chat	2337		
M.			
K.			
Mz.			
Mc.			
V.			
S.			
S.			
A			
R.			
Pe.			
G.			
T.D.	2343		

Loc. in Sec. SW SE SW

Geol.

Conty Sunflower

Pool

NOV 23 '56

COMPLETE

Date Comm. 11-2-56

8 5/8" @ 150 drlg. 1980 NOV 13 '56

4½ @ 2339 NOV 21 '56 CO 2343

Frac Flwd 34½ BO 1 hr

P. 20 Bopd + wtr.

Cp. Lse. No. Sec. T. R.