

Lyon


FORM 51 25M 8-50 WESTERN

7

Section 27 Township 18 Range 12 E

Well No. # 1 Robertson

Company Ben Brack Oil

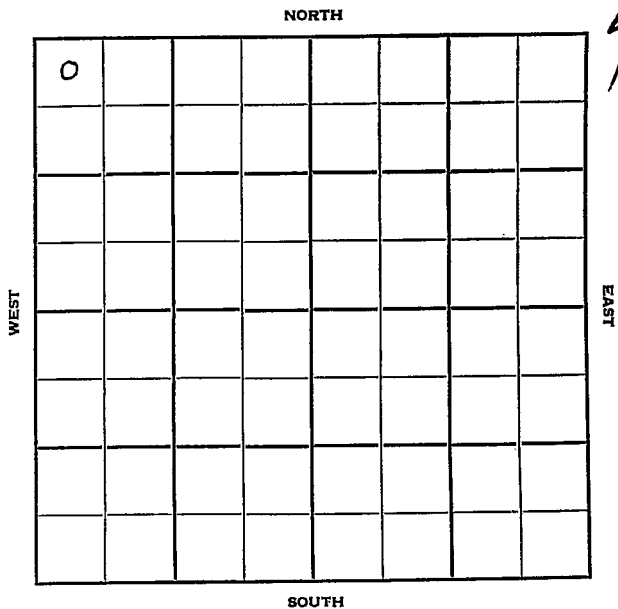

Lyon

Sec. 27 Twp. 18 R. 12 E Y

Well No. # 1 Robertson Farm

Ben Brack Oil Company

Contractor

Wildcat


330 Ft. from N. Line

\_\_\_\_\_ Ft. from S. Line

\_\_\_\_\_ Ft. from E. Line

330 Ft. from W. Line

NW NW NW

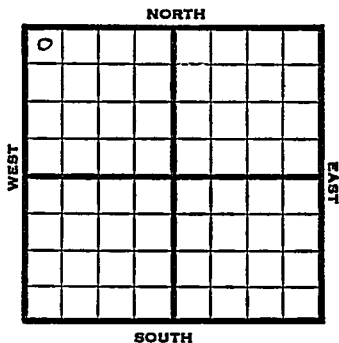

1951

REPORT

4/11

Set surface

6/20

Location abandoned

**ABANDONED**




County Lyon State Kansas

Sec. 27 (Blk. 18) (Sur. 12E) (Twp.) Map No.

Operator Ben Brack Oil

Well No. 1 Farm Robertson

Elev: \_\_\_\_\_ Location NW NW NW

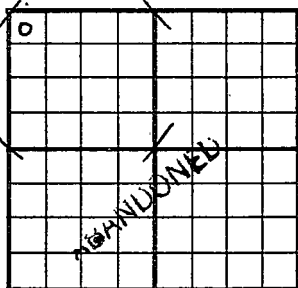

330 Ft. From N Line NW

330 Ft. From W Line Quarter

1st. Report \_\_\_\_\_

Completion JUN 20 1951

Remarks Wildcat

Spudding Date. 4-6-51

Drlg. Data \_\_\_\_\_

Location abd.

J. E. TYRA