


Section 28 Township 18 Range 4E

Well No. #1 Holub

Company B D W Oil

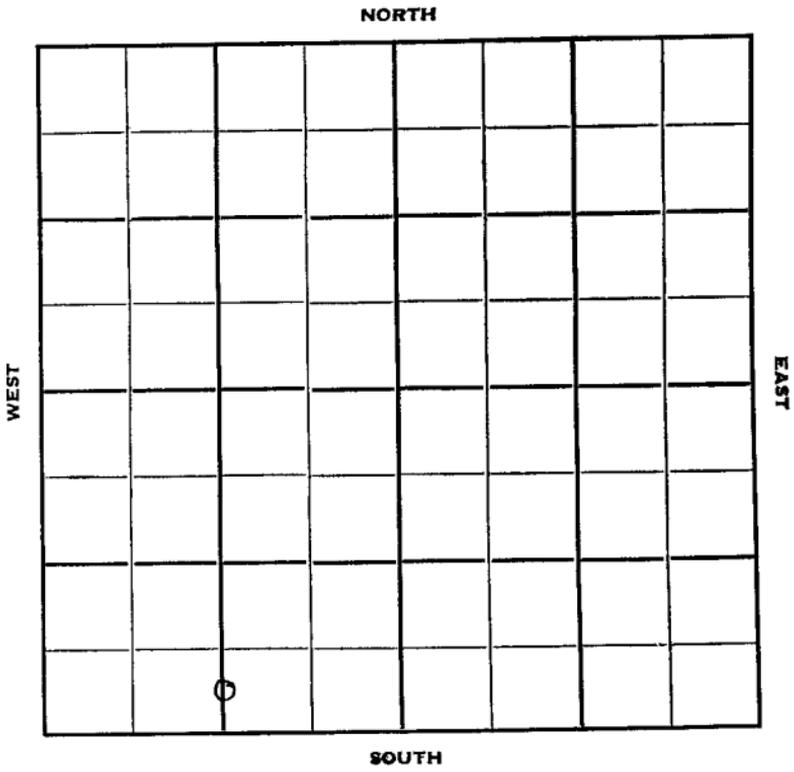

Marion
18

KANSAS
R. 4E

Sec. 28

Twp.

R.

Well No. #1 Holub Farm

B-D-W Oil Company

Slusser - Contr. Contractor
Antlope


Ft. from N. Line

330' Ft. from S. Line

Ft. from E. Line

1320' Ft. from W. Line

S/2 S/2 SW

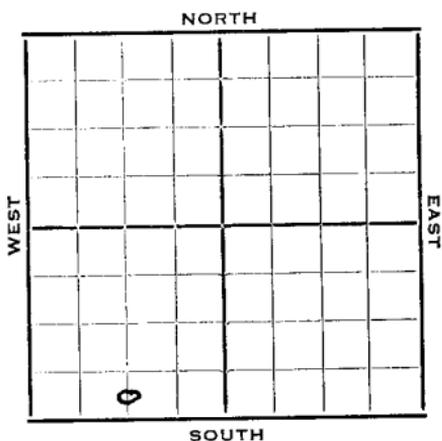

1952

REPORT

2/6

Spud 2-2-52
8" @ 109
Lost Circ 851

2/13

KC 1840' Miss 2410'
RTD 2412' 5" @ 2412' WOCT

2/20

Spud 2-2-52
Oil well TD 2418'
8" @ 109 KC 1840' Miss 2410'
TD 2412' 5" @ 2412 DD 2418'
S/40 BO 6 hr.
Comp. 60 BOPD

COMPLETED

County **Marion** State **Kansas**

Sec. **28** (Blk. **18** (Sur. **4E** Map No. (Twp.) (Rge.)

Operator **B-D-W 011**

Well No. **1** Farm **Holub**

Elev. Location **S/2 S/2 SW**



330 Ft. From **S** Line **SW**

1320 Ft. From **W** Line **Quarte**

1st. Report **FEB 6 1952**

Completion

Remarks

Slusser - Contr.

Spudding Date **2-2-52**

Drig. Data **Antlope**

8" @ 109 Lost Circ 851

J. G. McGEHEE


County Marion State Kansas

Sec. 28 (Blk. Twp.) 18 (Sur. Rge.) 4E Map No.

Operator B-D-W Oil

Well No. 1 Farm Holub

Elev. Location C S L S $\frac{1}{2}$ SW

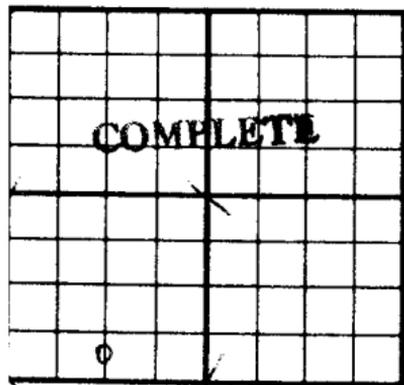

330 Ft. From S Line SW

1320 Ft. From W Line Quarter

1st. Report

Completion FEB 20 1952

Remarks Antelope Pool

Slusser Drlr. - Contr.

Spudding Date 2-2-52

Drig. Data Oil well TD 2418

8" @ 109 KC 1840 Miss. 2410

TD 2412 5" @ 2412 DD 2418

S/ 40 bo 6 hr. Comp. 60 bopd