


Marion

KANSAS

Section 28 Township 18 Range 4E

Well No. #2 Holub

Company B.D. & W Oil

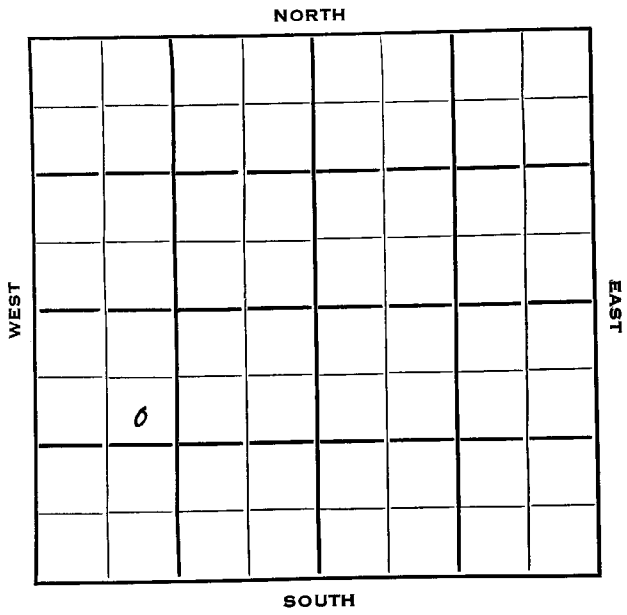

Marion KANSAS ✓

Sec. 28 Twp. 18 R. 4 EWell No. # 2 Holub Farm

B, D & W Oil

Company

~~Slusser Drig.~~
Berexte

Contractor


*Antelope Pool*990 Ft. from N. Line

Ft. from S. Line

Ft. from E. Line

990 Ft. from W. Line

SE NW SW

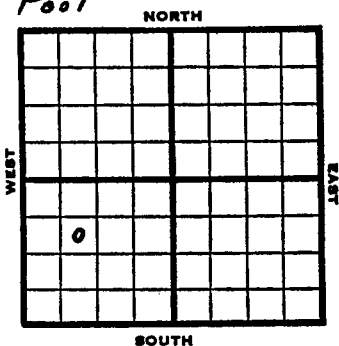

1953

Elev. 1451'

REPORT

1451 DF

2/4

RUR

3/4

Spud 2-4-53

Oil Well

TD 2451

10" @ 90

KC 1847, Miss 2407

TD 2409 ✓

5" @ 2409

DD 2451

FU 70' oil, 600' wtr. 14 hrs.

Comp. 5 bopd 35 bw

COMPLETED

1956

O.W.W.O.

8/29

Old Info. OTD 2409' Was Miss Prod.

NEW INFO: MIRT. Wash down DD 2858
for Arb. disposal.

Tops: KC 1847', Miss. 2407' V 2770'

OVER

1956

9-5

Tops:

KC 1847, M 2407, V 2770, S 2918,

A 2952

TD 2999

Old info - OTD 2409; was Miss prod

New info - MIRT Wash Down

DD 2858 for Arb. disposal

4 $\frac{1}{2}$ linen @ 2885 CO 2999

Comp for SWD well

Abandoned

ABANDONED

O.W.W.O.

County **Marion** Elev. **1451 DF**
 Sec. **28** Twp. **18S** Rge. **4E**
 Company **B. D. & W.**
 Farm Name **Holub**

No. **2****OWNO**

TOPS	DEPTH	LOG	DATUM	Loc in Sec.
Anh.				SE NW SW
Tr.				
Dg.				
BL.				
L.				Geol. _____
K.C.	18h7			Contr. _____
B.K.C.				Berents
Ce.				Pool _____
C.	2407			Antelope
M.				
M.				
K.				
Mz.				
Me.				
V.	2770			
S.				
S.				
A.				FIRST REPORT
R.				
Pe.				
G.				
TD				AUG 29 '58

Date Comm. **Old info - OTD 2409; was Miss prod.**

New info - MIRT Wash down DD 2858; for Arb. disposal

NO

County Martion Elev. 1151 DF
 Sec. 28 Twp. 18S Rge. 4E
 Company B. D. & W.
 Farm Name Holub

No. 2OWWO

TOPS	DEPTH	LOG	DATUM
Anh.			
Tr.			
H.			
Tr.			
Dg.			
Bl.			
L.			
K.C.	1847		
B.K.C.			
Ce.			
C.	2407		
M.			
M.			
K.			
Mz.			
Mo.			
V.	2770		
S.	2918		
S.			
A.	2952		
R.			
PC.			
G.			
TD	2999		

Loc. in Sec.

SE NW SW

Geol.

Contr.

Berentz

Pool

Antelope

SWDW

ABANDONED

0

SEP 5 '56

Date Comm. Old info - OTD 2409; was Miss
prod.

New info - MIRT Wash down DD 2858;

for Arb. disposal SEP 5 '56 4 1/2 Lines
@ 2885 to 2999 comp. for
SWD well

County Marion State Kansas

County					
Sec.	28	(Blk. Twp.)	18	(Sur. Rge.)	4E Map No.

Operator B, D & W Oil

Well No. 2 Farm Holub

Elev.	1451	Location	SE NW SW
-------	------	----------	----------

COMPLETED

0

990 Ft. From N Line SW

990 Ft. From W Line Quarter

1st. Report

Completion MAR 4 1952

Remarks _____

Slusser Drlg. - Contr.

Spudding Date 2-4-53

Drilg. Data Oil well TD 2451

10" @ 90 Kc 1847 Miss. 2407

TD 2409 5" @ 2409 DD 2451 FU 70' oil

600' wtr. 14 hr.

Comp. 5 bopd 35 bw

J. G. McGEHEE