

C.W.D.D


Section 28 Township _____ Range 4E

Well No. 3 #1 Holub

Company H. H. Schlageek et al *B-D + W OIL*

Antelope Pool

NORTH

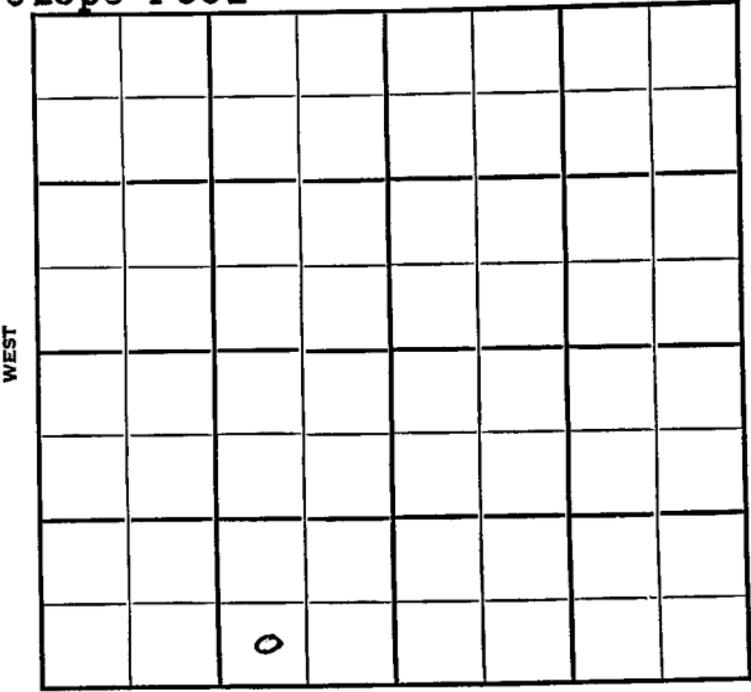

WEST

EAST

SOUTH

Map No. _____ Sec. 28 Twp. 18 R. 4E


Well No. 1 Holub

H. H. Schlageck et al. Company

FIRST REPORT Contractor

SW SE SW

SECTION PLAT

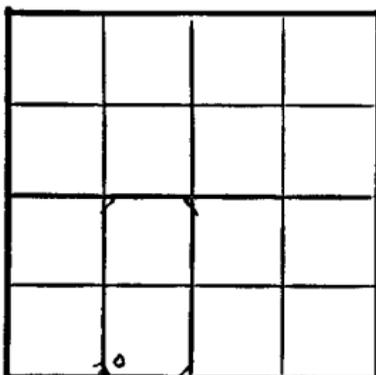

_____ Ft. from N. Line

330 Ft. from S. Line

990 Ft. from E. Line

_____ Ft. from W. Line

Marion County

Location X

Rig up _____

Drilling and Remarks:

RECORD

Cased _____ in., _____ ft.

Sand _____

Gas _____

Oil _____

Total Depth _____

PRODUCTION

1st 24 hrs. Nat. _____

1st 24 hrs. after shot _____

Gas _____ Cu. Ft.

Dry Hole _____

Abandoned _____

Date

OCT 29 1947

19

S. J. LEWIS

Scout

Map No. 26 Sec. 28 Twp. 18 R. 4E

Well No. 1 Holub

H. H. Schlageck et al. Company

COMPLETE

Contractor

SW SE SW

E 11447
SECTION PLAT

_____ Ft. from N. Line

330 Ft. from S. Line

990 Ft. from E. Line

_____ Ft. from W. Line

	0		

Marion County

Location _____

Rig up _____

Drilling and Remarks:

KC 1835
6" @ 1840
2000 acid
Pump 35 oil + 15W
Pat
36 2/3

RECORD

Cased _____ in., _____ ft.

Sand _____

Gas _____

Oil

Total Depth 1832

PRODUCTION

1st 24 hrs. Nat. _____

1st 24 hrs. after shot _____

Gas _____ Cu. Ft.

Dry Hole _____

Abandoned _____

Date

MAR 3 1948 19

S. LEWIS Scout