

KANSAS


Form 51—5M—7-39—Palace

Marion

Section 28 Township 18 Range 4-E

Well No. #1 Krach (Krach)

Company H. H. Royer

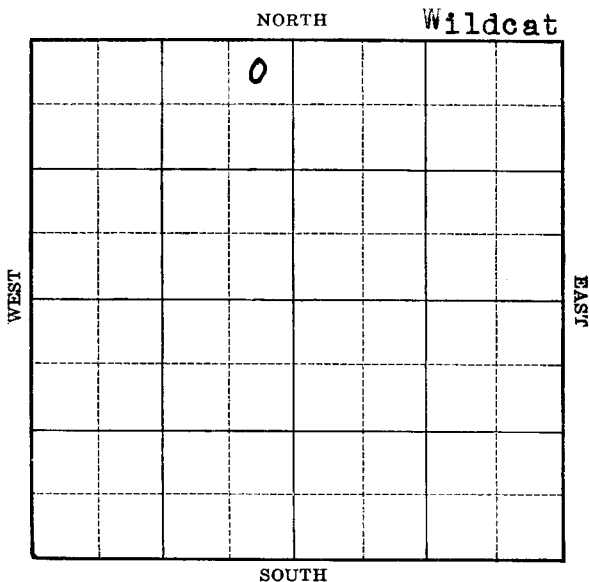

KANSAS


Marion

Sec. 28 Twp. 18 R. 4-EWell No. #1 Krach FarmH. H. Royer Company

(Wildcat)

330 Ft. from N. Line Ft. from S. Line330 Ft. from E. Line Ft. from W. Line

Elev. 1441

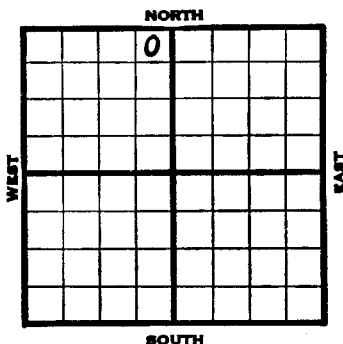

1939	REPORT
12/27	Machine.
.940	
.4	Spud 50' SD.
1/11	" "
1/18	" "
.25	" "
2/1	" "
2/8	15" - 115'
	Drlg. 325'
2/15	Drlg. 650'
2/23	SD 780'
2/29	12" - 775'
	Drlg. 1345'
3/8	10" - 1355' Drlg. 1385'
3/14	8" - 1710' Drlg. 1830'
3/21	6" - 2110'
	SD 2128'
3/28	Drlg. 2340'
4/4	SD 2340'
	OVER

1940
1/10

Serial 451
T.D. 2452

ABANDONED

KANSASMarionMap No. 26 Sec. 28 Twp. 18 R. 4EWell No. 1 KraohH. H. Royer

Company

~~FIRST REPORT~~

Contractor

SECTION PLAT

NE NW

330 Ft. from N. Line

Ft. from S. Line

330 Ft. from E. Line

Ft. from W. Line

WILDCAT

Location _____

Rig up _____

Drilling and Remarks:

Machine

RECORD

Cased _____ in., _____ ft.

Sand _____

Gas _____

Oil _____

Total Depth _____

PRODUCTION

1st 24 hrs. Nat. _____

1st 24 hrs. after shot _____

Gas _____ Cu. Ft.

Dry Hole _____

Abandoned _____

Date

DEC 27 1939 19U. S. 127410

Scout

Marion

Map No. 26 Sec. 28 Twp. 18 R. 4EWell No. 1 Krach

H. H. Royer

Company

Contractor

ABANDONED

NE NW

330 Ft. from N. Line Ft. from S. Line330 Ft. from E. Line Ft. from W. Line

WILDCAT

SECTION PLAT

		o	

Location Rig up

Drilling and Remarks:

H + A.

RECORD

Cased in., ft.Sand Miss 2431Gas Oil Total Depth 2452

PRODUCTION

1st 24 hrs. Nat. 1st 24 hrs. after shot Gas Cu. Ft.Dry Hole Abandoned

Date

APR 10 1940 19 LEWIS Scout