


W. Barton

Sec. 28 Twp. 18 R. 4E

Well No. #3 ~~#1~~ Holub Farm
H.H. Schlageck et al B-D & W OIL Company

Antelope Pool

_____ Ft. from N. Line
330 Ft. from S. Line
990 Ft. from E. Line
_____ Ft. from W. Line
SW SE SW

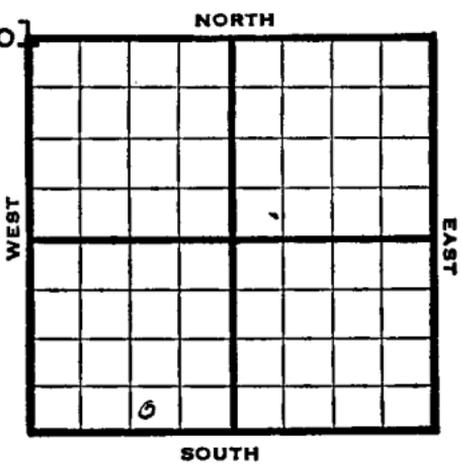

| 1947 | Elev. 1447' | REPORT |
|-------|-------------|---|
| 10/29 | | Location |
| 11/5 | | Mach. |
| 11/12 | | Drlg. 300' |
| 11/19 | | 12" @ 111' Drlg. 475' |
| 11/25 | | 10" @ 1000' Drlg. 1075' |
| 12/3 | | 8" @ 1525' Drlg. 1600' |
| 12/10 | | Drlg. 1860' |
| 12/17 | | S.D. |
| 12/30 | | KC 1835' 6" @ 1840' CO |
| 1948 | | |
| 1/7 | | " |
| 1/14 | | TD 1852' 2000 acid Pump 5l bbls oil 5 hrs |
| 1/21 | | " |
| 1/26 | | " |
| 2/4 | | " |

OVER

1948

2/11 TD 1852'
2000 acid
Pump 51 bbls. oil 5 hrs.

2/18 "

2/25 "

3/3 KC 1835'
6" @ 1840'
2000 Acid
Pump 35 oil / 15 W Pot.
Gr. 36°
Total Depth 1852'

COMPLETED

O.W.D.D

1953

10/14 KC 1835'
OTD 1852'
6" @ 1840'
DD

12/2 Oil Well
TD 2407'
KC 1835'
OTD 1852'
6" @ 1840' DD
Miss 2400'
TD 2407'
CO to 2407'
P/15 bo 30 bw
F/load
F/2 boph died
Comp. 40 bopd

COMPLETED

Kansas

Map No. _____ Sec. 28 Twp. 18 R. 4EWell No. 3 Holub

B-D & W

Company

CORRECTION

Contractor


SW SE SW

SECTION PLAT

_____ Ft. from N. Line

330 Ft. from S. Line990 Ft. from E. Line

_____ Ft. from W. Line

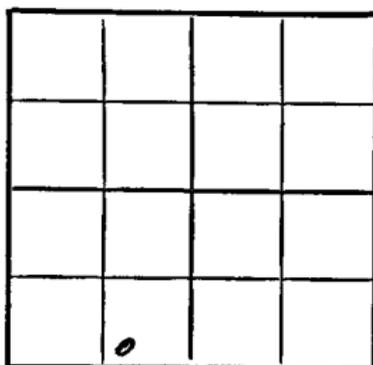

Marion County

Location _____

Rig up _____

Drilling and Remarks:

Reported

#1 Holub

RECORD

Cased _____ in., _____ ft.

Sand _____

Gas _____

Oil _____

Total Depth _____

PRODUCTION

1st 24 hrs. Nat. _____

1st 24 hrs. after shot _____

Gas _____ Cu. Ft.

Dry Hole _____

Abandoned _____

Date

NOV 24 1933J. G. McGEHEE Scout

