


Section 3 Township 18 Range 1E

Well No. 1 Urbanek

Company Slusser Drlg. et al

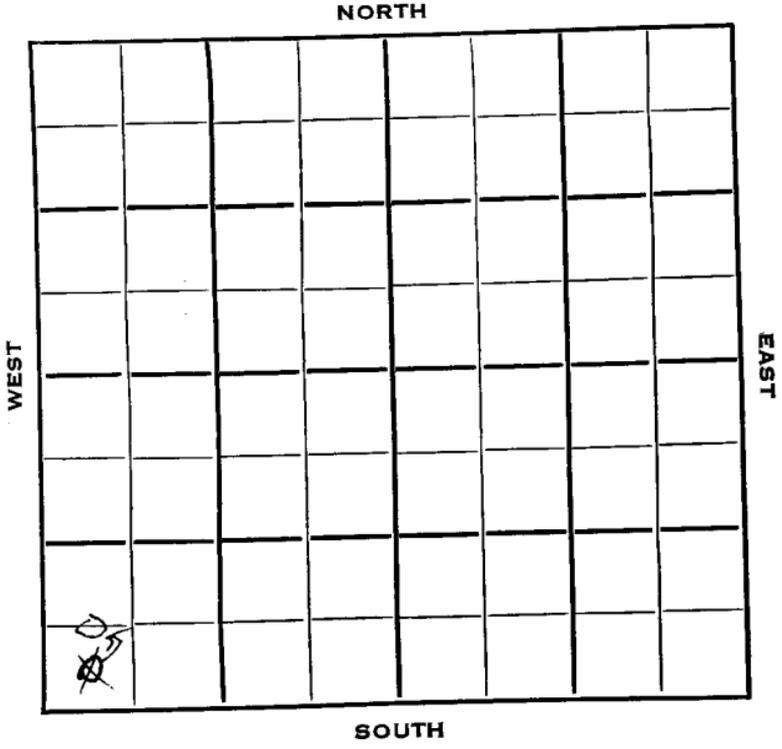

Marion KANSAS

SEC. 3 TWP. 18 R. 4 E ✓

WELL NO.

1 Urbanek

FARM

COMPANY

Slusser Drlg. et al

CONTRACTOR

Slusser Drlg.


Lost Springs Pool

_____ Ft. from N. Line

330 660 _____ Ft. from S. Line

_____ Ft. from E. Line

330 _____ Ft. from W. Line

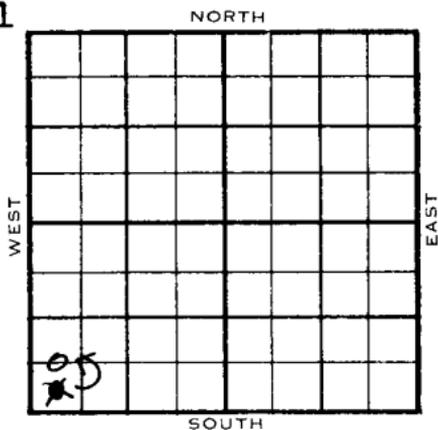

~~SW SW SW~~
2 WL SWSW

	ELEVATION	REPORT
1953	1438'	

12/9	Spud 11-3-53 8" @ 103'	Drlg. 2059'
------	---------------------------	-------------

2/3	Spud 11-3-53 D&A TD 2428' 8" @ 103' Miss 2366' TD 2368' 5" @ 2368' DD 2428' 2 bo 28 bwpd D&A	
-----	---	--

ABANDONED

Kansas

Map No. _____ Sec. 3 Twp. 18 R. 4EWell No. 1 Urbanek

Slusser Drlg. _____ Company

CORRECTION Contractor

C W L SW SW

SECTION PLAT

_____ Ft. from N. Line

660 Ft. from S. Line

_____ Ft. from E. Line

330 Ft. from W. Line

o			

Merion County

Location _____

Rig up _____

Drilling and Remarks:

Reported
SW SW SW

RECORD

Cased _____ in., _____ ft.

Sand _____

Gas _____

Oil _____

Total Depth _____

PRODUCTION

1st 24 hrs. Nat. _____

1st 24 hrs. after shot _____

Gas _____ Cu. Ft.

Dry Hole _____

Abandoned _____

Date

DEC 30 1953
19

J. G. McGENE

Scout

