

Chase ✓

Map No. KANS Sec. 3 Twp. 18 R. 9
 Well No. 1 White Farm
Watshorn & Co. Company

NORTH

WEST

EAST

SOUTH

10

Location _____

Drilling Remarks _____

Rig Up _____

Drilling Remarks _____

RECORD

Cased _____ in. _____ ft.

Sand _____

Gas _____

Oil _____

Total Depth _____

PRODUCTION

1st 24 hrs. Nat. _____

1st 24 hrs. after shot _____

Gas _____ cu. ft.


Dry Hole _____

Abandoned _____

Map No. Kansas Sec. 3 Twp. 18 R. 9Well No. 1 White FarmWatchorn O & G. Company330 Ft. from N. Line

Ft. from S. Line

Ft. from E. Line

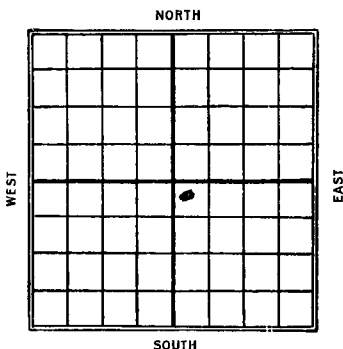330 Ft. from W. Line

Date

REPORT

19266/30Location7/87/15Rig & tools7/22Spudding7/28Drly 3008/48/11" 10008/188/25Drly 20008-3122609/159/229/29Drly 2975'10/6R & A 2970'

Wade
K27 KANSAS
 Map No. _____ Sec. *7* Twp. *18* R. *9*
 Well No. *1* *White*
Watehorn Oil Gas Co Company
 _____ Contractor

FIRST REPORTS

SECTION PLAT

330 _____ Ft. from N. Line
 _____ Ft. from S. Line
 _____ Ft. from E. Line
330 _____ Ft. from W. Line

		o	

✓
 Location _____
 Rig up _____
 Drilling and Remarks:

RECORD

Cased _____ in., _____ ft.
 Sand _____
 Gas _____
 Oil _____
 Total Depth _____

PRODUCTION

1st 24 hrs. Nat. _____
 1st 24 hrs. after shot _____
 Gas _____ Cu. Ft.
 Dry Hole _____
 Abandoned _____

Date

JUN 30 1926


192

CHAS. L. SHERWOOD

Scout •

K27 **KANSAS** *3* *18* *9*
 Map No. _____ Sec. _____ Twp. _____ R. _____
 Well No. *1* *White* Farm _____
Watchorn Oil & Gas Co. Company _____

NORTH

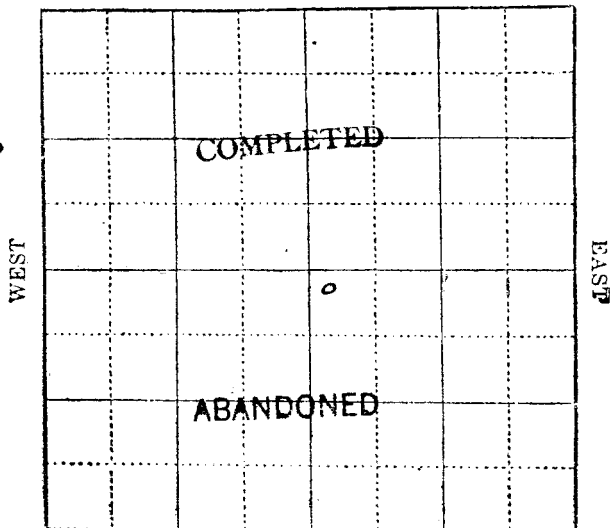

SOUTH

Location _____

Rig up _____

Drilling and Remarks:

RECORD

Cased _____ in., _____ ft.

Sand _____

Gas _____

Oil _____

Total Depth *2970***PRODUCTION**

1st 24 hrs. Nat. _____

1st 24 hrs. after shot _____

Gas ☒ Cu. Ft.Dry Hole ☒Abandoned ☒

DQ 9
2970'

Date
OCT 6 1926

192

CHAS. L. SHERWOOD

Scout