


Marion

Section 30 Township 18 Range 4 E

Well No. #1 Switak

Company Loomis & Artnell

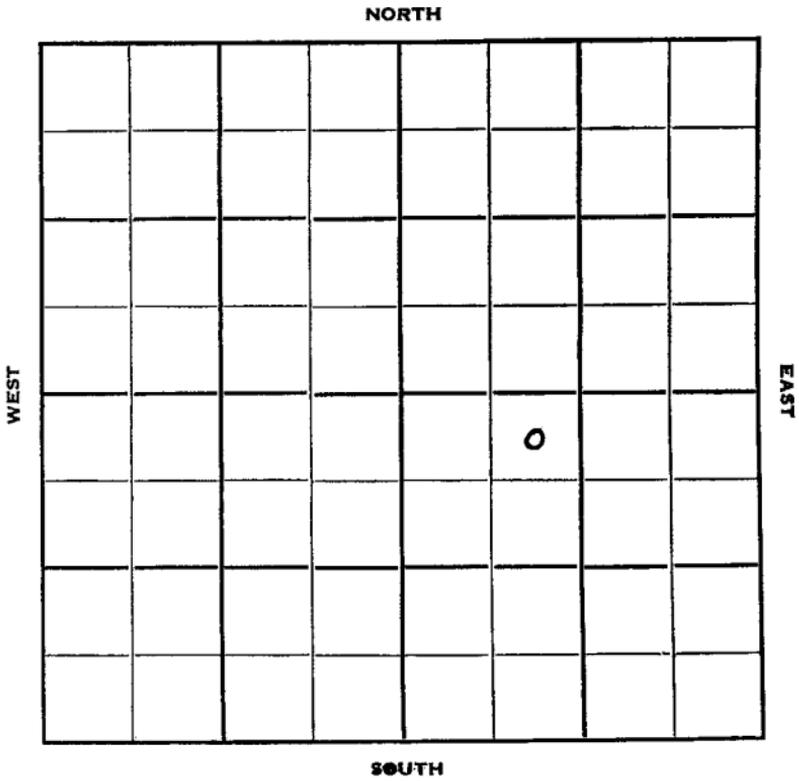

Sec. 30 Twp. 18 R. 4E

Well No. #1 Switak Farm

Loomis & Artnell Company

Loomis - Contr. Contractor

Wildcat


330' Ft. from N. Line

_____ Ft. from S. Line

_____ Ft. from E. Line

990' Ft. from W. Line

NE NW SE

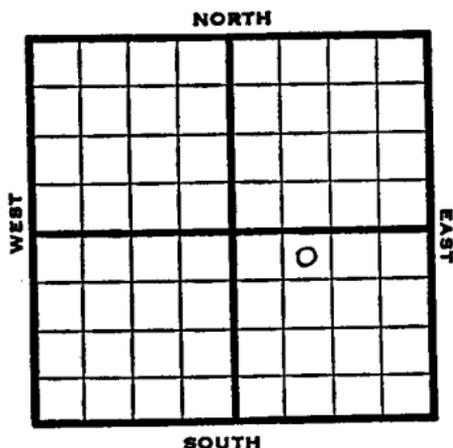

1951 Elev. 1416' REPORT

1/31 Location

8/22 Spud 2-27-51

D & A TD 2840' 15" @ 94

13" @ 310' 10" @ 1000 8" @ 11480

KC 1848' 7" @ 2185' Miss chert

2375' TD 2396' 6-5/8" @ 2389

Miss lime 2435' 5" @ 2471'

Kh. 2512' Misenor 2665' TD 2667'

Maq. 2703' Viola 2708' TD 2840'

D & A

ABANDONED

