

Marion


KANSAS
5 E

SECTION 31 TOWNSHIP 18 S RANGE 5 E

WELL NO. # 1 Benthe

COMPANY R. E. Wade NE 12

NORTH ~~NE~~ NW SW

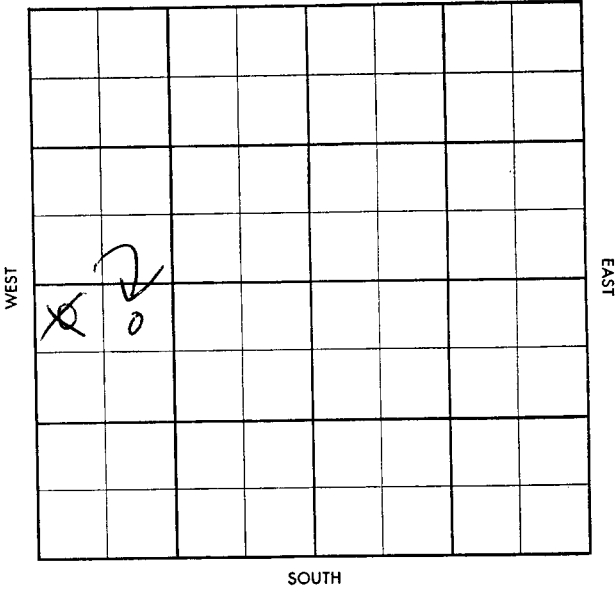

~~NO. 1~~ ~~NO. 2~~
~~NO. 3~~ ~~NO. 4~~

S-513-B

County Marion Elev. _____
 Sec. 31 Twp. 18 Rge. SE
 Company R. E. Wade
 Farm Name Benthe No. 1

TOPS	DEPTH	LOG	DATUM
Anh.			
Tp.			
H.			
Tr.			
Dg.			
B.L.			
L.			
K.C.			
B.K.C.			
Ce.			
C.			
M.			
M.			
K.			
Mz.			
Mq.			
V.			
S.			
S.			
A.			
R.			
Pf.			
G.			
T.D.			

Loc. in Sec. NW NW SW

Geol. _____
 Contr. Midwest

Pool Antelope

JUL 23 1958
FIRST REPORT

Date Comm. 7-19-58
8" @ 150 drlg. 1120

Co. _____
 Lse. _____
 No. _____
 Sec. _____
 T. _____
 R. _____

