
Marion KANSAS

SECTION 32 TOWNSHIP 18S RANGE 4E

WELL NO. #1 Kroupa

COMPANY Roland Jones

NORTH SE SE NE

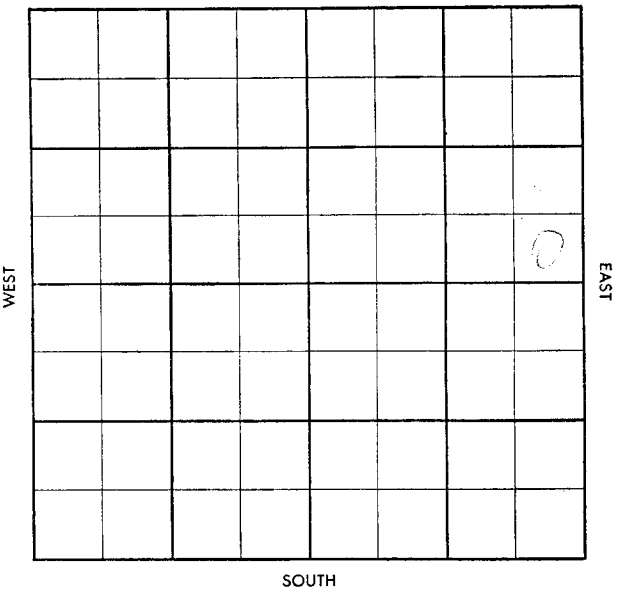

S-513-B

Co.

County Marion Elev.

Sec. 32 Twp. 18 Rge. 4E

Company Roland Jones

Farm Name Krenpe No. 1


TOPS	DEPTH	LOG	DATUM
Anh.			
Tp.			
H.			
Tr.			
Dg.			
B.L.			
L.			
K.C.			
B.K.C.			
Ce.			
C.			
M.			
M.			
K.			
Mz.			
Mq.			
V.			
S.			
S.			
A.			
R.			
Pf.			
G.			
T.D.			

Loc. in Sec. SE SE NE

Geol.

Contr. Slusser Drlg

Pool Antelope

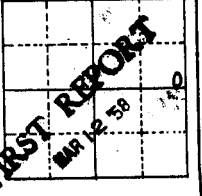

Iss.

No.

Sec.

Date Comm.

Location

Twp. ____ Pool ____

Co. ____ Feet ____

S-513-B

County Marion Elev. 1492DF1435RB

Sec. 32 Twp. 18 Rge. 4E

Company Roland Jones

Farm Name Kroupa No. 1

TOPS	DEPTH	LOG	DATUM
Anh.			
Tb.			
H.			
Tr.			
Dg.			
B.L.			
L.	1836		
K.C.			
B.K.C.			
Ce.			
C.			
M.	2388		
M.			
K.			
Ms.			
Mq.			
V.			
S.			
S.			
A.			
R.			
Pf.			
G.			
T.D.	2395		

Loc. in Sec. SE SE NE

Geol. ____

Contr. Slusser Drlg.

Pool Antelope

COMPLETE 0

APR 23 '58

Date Comm. 3-28-58

Location MAR 19 '58 MAR 28 '58 APR 2 '58 8" 185/150

$1810 APR 9 '58 5½ 2391 CO

DD 2397 APR 16 '58 LO DD 2402 TD

FD 366 FH 65% oil Frac

2x1 SLd APR 23 '58 F 2 BOph +14

BWph POP F 15 BO +98BW

pd

¢