


Section 32 Township 18 Range 4 E

Well No. # 1 Rudolph

Company Alpine Oil & Royalty

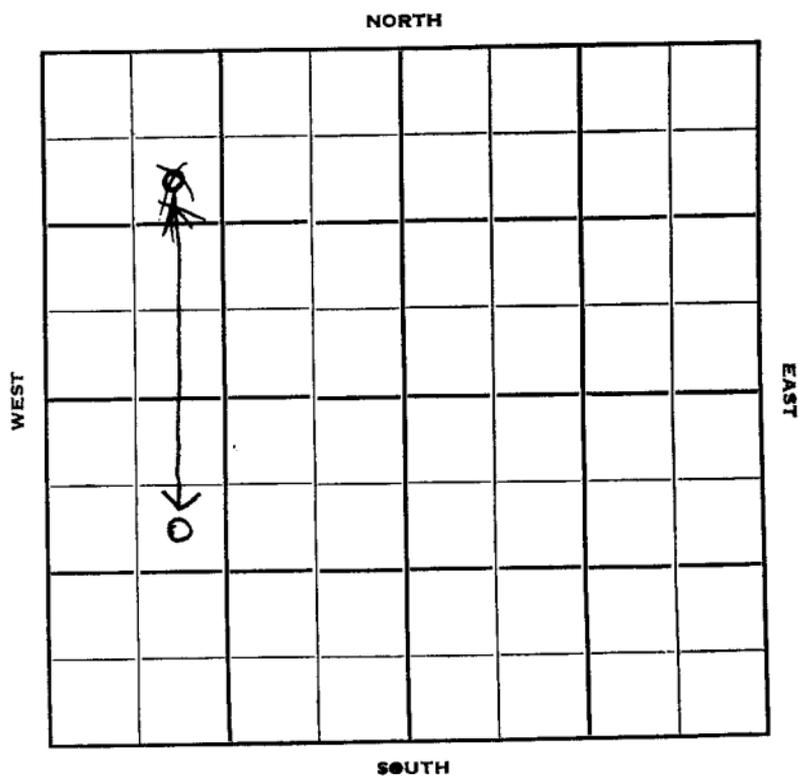

Marion

Sec. 32 Twp. 18 R. 4 E ✓

Well No. # 1 Rudolph Farm

Alpine Oil & Royalty Company

Contractor


990 Wildcat
Ft. from N. Line

Ft. from S. Line

Ft. from E. Line

990 Ft. from W. Line

SE NW ^{SW} NW

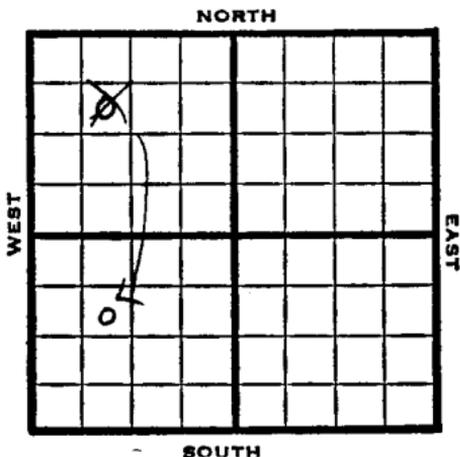

1951

Elev. 1401' REPORT

2/28
4/25

Set surface

D&A TD 2433

8" @ 117'

Miss 2377-82 KC 1822

BKC 2324

5" @ 2379 TD 2397'

FU 100' oil 600' wtr 12 hr.

DD 2433 HFW D&A

ABANDONED

2377
2324
100

2377
2324
100

Kansas

Map No. _____ Sec. 32 Twp. 18 R. 4E

Well No. 1 Rudolph

Alpine Oil & Royalty Company

CORRECTION Contractor

SE NW SW

SECTION PLAT

990 Ft. from N. Line

_____ Ft. from S. Line

_____ Ft. from E. Line

990 Ft. from W. Line

o			

Marion County

Location _____

Rig up _____

Drilling and Remarks:

Reported
SE NW NW

RECORD

Cased _____ in., _____ ft.

Sand _____

Gas _____

Oil _____

Total Depth _____

PRODUCTION

1st 24 hrs. Nat. _____

1st 24 hrs. after shot _____

Gas _____ Cu. Ft.

Dry Hole _____

Abandoned _____

Date

MAR 7 1951

J. E. TYRA

Scout

