Marion


KANSAS

SECTION 32 TOWNSHIP 18S RANGE 4E

WELL NO. #1 ~~Spacek~~ Spachek

COMPANY Roland Jones

NW NE SE

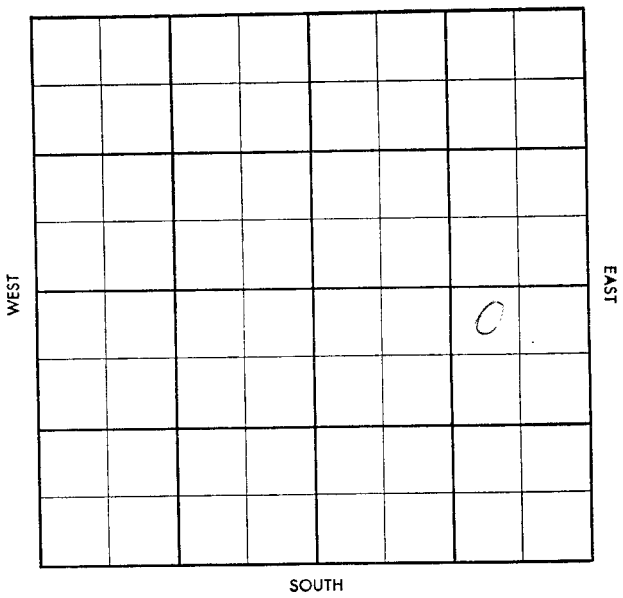

FORM 504-3 SUNRAY

S-513-B

Co.

County Marion Elev.

Sec. 32 Twp. 18 Rge. 4E

Company Roland Jones

Farm Name Spacek No. 1

TOPS	DEPTH	LOG	DATUM
Anh.			
Tp.			
H.			
Tr.			
Dg.			
B. L.			
L.			
K.C.			
B.K.C.			
Ce.			
C.			
M.			
M.			
K.			
Mz.			
Mq.			
V.			
S.			
S.			
A.			
R.			
Pf.			
G.			
T.D.			


Loc. in Sec. NW NE SE

Geol.

Contr. Slusser

Lse.

Pool Antelope

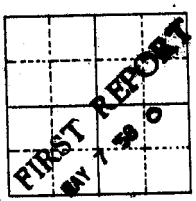

No.

Date Comm. 5-4-58

8" @ 200 drlg. 1846

Sec.

T.

R.

Twp. Pool

CORRECTION Co. Facet

5-513-B

County Marion Elev 1436 DF 1426 RB

Sec. 32 Twp. 18 Rge. 4E

Company Roland Jones

Farm Name ~~Spaeck~~ Spachek No. 1

TOPS	DEPTH	LOG	DATUM
Anh.			
Tp.			
H.			
Tr.			
Dg.			
B. L.			
L.			
K.C.			
B.K.C.			
Ce.			
C.			
M. Chat	2382		
M.			
K.			
Mz.			
Mq.			
V.			
S.			
S.			
A.			
R.			
Pf.			
G.			
T.D.	2389		

Loc. in Sec. NW NE SE

Geol.

Contr. Slusser

Pool Antelope

COMPLETE

JUN 11 '58

Date Comm. 5-4-58

8" @ 200 drlg. 1846 MAY 14 '58 7" 2388

WOCT MAY 21 '58 MAY 28 '58 JUN 3 '58 JUN 11 '58 CO

2389 TD frac & 10 BFPH 80%

w pop P 25 Bopd + 100 BW

Co. Lse. No. Sec. T. R.