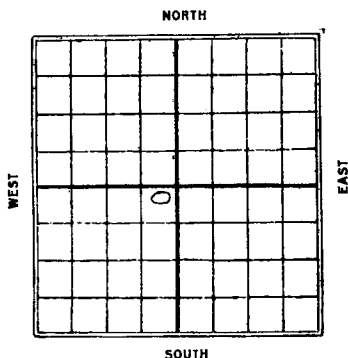


Map No. Kansas Sec. 32 Twp. 18 R. 7Well No. 1 Lips FarmPreston & Pasewalk Company200 Ft. from N. Line

_____ Ft. from S. Line

200 Ft. from E. Line

_____ Ft. from W. Line

Date 1925 REPORT8/19 pudding9/24 _____10/1 _____10/8 Spud B.H10/16 _____10/22 only 300'10/29 _____11/6 dry @ 650'11/13 _____11-19 only 750'11-27 _____12/3 5/10 950'12/10 only 1100'12/17 5/10 _____12/23 _____12/31 fishing collapsed esp 1100'19261/8 _____1/14 _____50 (conection in depth) sand1008 1021' Est 8 M gas,
will mud off.

2/27 - second gas sand 1100' ..
Est 8 M. mudded off.
using 8" 1200'

3/4 - _____

3/10 - Dlg 1520'

3/17 - Drlg 1930' H.F.W.

2/24 - _____

3/5 - _____

3/10 - _____

3/18 - S.D.-S.D. 26.62 plugged
back to gas sand.

3/25 - _____

4/1 - _____

4/7 - Sand 1008-1021

" 1160-1185

Top Lane 1930 H.F.W. T.D. 2262

P.B. to 1160-85 3 99 Gas

Chase Co

Map No. **KANSAS** Sec. 32 Twp. 18 R. 7Well No. 1 Hips
Horton & Radewalk Company

Contractor

FIRST REPORTS

SECTION PLAT

200 Ft. from N. Line

Ft. from S. Line

200 Ft. from E. Line

Ft. from W. Line

	6		

Location -----

Rig up -----

Drilling and Remarks:

Spudding

RECORD

Cased ----- in., ----- ft.

Sand -----

Gas -----

Oil -----

Total Depth -----

PRODUCTION

1st 24 hrs. Nat. -----

1st 24 hrs. after shot -----

Gas ----- Cu. Ft.

Dry Hole -----

Abandoned -----

Date

SEP 19 1925

CHAS. L. SHERWOOD

192

Scout

1527 KANSAS Sec. 32 Twp. 18 R. 7

Well No. 1
 Patton & Rosewater Company

Contractor

COMPLETED

SECTION PLAT

200 Ft. from N. Line

Ft. from S. Line

200 Ft. from E. Line

Ft. from W. Line

	o		

Location

Rig up

Drilling and Remarks:

665 Sand 1008-1021'

" " 1160-1185'

Stop Aug 1930 HFW

20 2262' Plugged

Back to 1160-85'

3 1/4 SA

RECORD

Cased _____ in., _____ ft.

Sand _____

Gas _____

Oil _____

Total Depth 2262'

PRODUCTION

1st 24 hrs. Nat. _____

1st 24 hrs. after shot. _____

Gas 3 1/4 Cu. Ft.

Dry Hole _____

Abandoned _____

Date

APR 7 1926

CHAS. L. SHERWOOD

192

Scout