

Marion

KANSAS


SECTION 33 TOWNSHIP 18S RANGE 4E

WELL NO. 2 Henke #1 Spudchek

COMPANY Harvey Elton

NORTH

~~G SW 1/4~~ W/2 E/2 SW

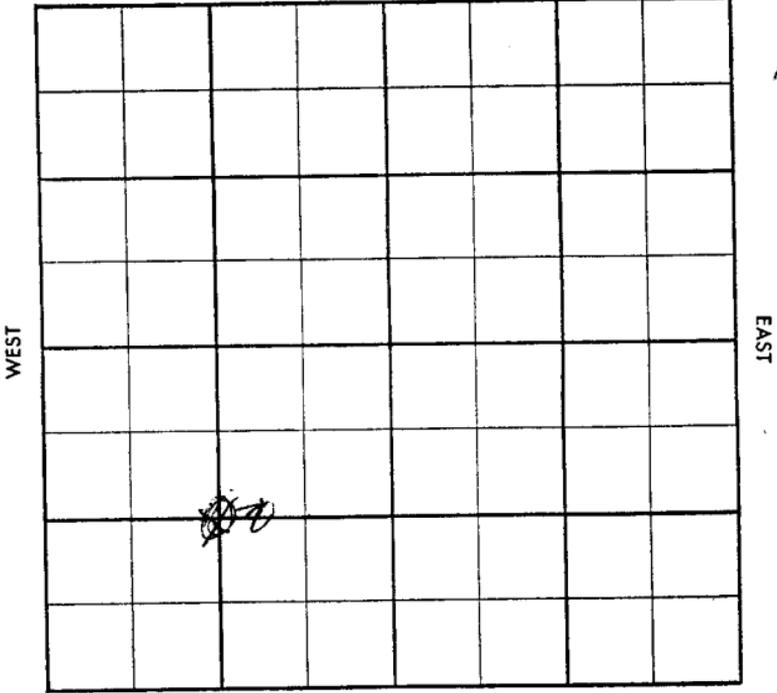

SOUTH

Twp. ~~Pool~~

Co. ~~Facet~~

S-513-B

County Marion Elev. _____
 Sec. 33 Twp. 18 Rge. 4E
 Company Harvey Elton
 Farm Name Spudchek No. 1

TOPS	DEPTH	LOG	DATUM
Anh.			
Tp.			
H.			
Tr.			
Dg.			
B.L.			
L.			
K.C.			
B.K.C.			
Ce.			
C.			
M. <u>Chat</u>	<u>2396</u>		
M.			
K.			
Mz.			
Mq.			
V.			
S.			
S.			
A.			
R.			
Pf.			
G.			
T.D.			

Loc. in Sec. C SW/4
 Geol. _____
 Contr. _____
Berents
 Pool _____

JUN 11 1958
FIRST REPORT

Date Comm. RTD 2400 5 1/2" 2399 WOCT

Co.

Lse.

No.

Sec.

T.

R.

~~Twp~~ ~~Pool~~
CORRECTION ~~Facet~~

S-513-B

County Marion Elev. _____
 Sec. 33 Twp. 18 Rge. 4E
 Company Harvey Elton
 Farm Name Henke Spuachek No. 12

TOPS	DEPTH	LOG	DATUM	Loc. in Sec.
Anh.				<u>C 3 1/4</u>
Tp.				<u>W 1/2 E 1/2 SW</u>
H.				
Tr.				
Dg.				
B.L.				
L.				Geol. _____
K.C.				Contr. _____
B.K.C.				
Ce.				<u>Gerentz</u>
C.				
M. <u>Chat</u>	<u>2396</u>			Pool _____
M.				
K.				
Mz.				
Mq.				
V.				
S.				
S.				
A.				
R.				
Pf.				
G.				
T.D.				

COMPLETE
 JUN 18 '58

Date Comm. 6-2-58

RTD 2400 5" 2399 100 FT JUN 18 58
DD 2420 TD 30 from 5 LD
PP P 25 130 P 24 10% W

\$