


Marion

KANSAS

SECTION 33 TOWNSHIP 18 RANGE 4E

WELL NO. #2 Holub "B"

COMPANY Ketner & Rhoades

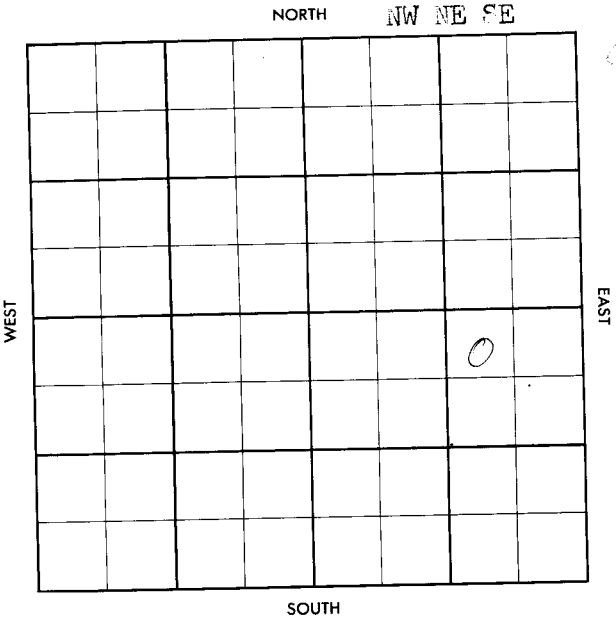



County arion Elev 1415  
 Sec. 33 Twp 18 Rge. 1E  
 Company Ketner & Rhoades  
 Farm Name Holub #211 No. 2

TOPS	DEPTH	LOG	DATUM	Loc. in Sec.
Anh.				NW 1/4 SE
TP.				
H.				
Tr.				
Dg.				
Bl.				
L.				
N.C.	<u>1920</u>			Geol.
B.K.C.				Contr.
Ce.				Sunflower
C.				Pool
M.	<u>2357</u>	<u>2360</u>		Antelope
M.				
K.				
Mz.				
Me.				
V.				
S.				
S.				
A.				
R.				
PE.				
G.				
ED	<u>2365</u>			COMPLETE FEB 27 '57

Date Comm. 1-20-57  
8" @ 168/ drl. 252 JAN 30 '57  
4 1/2 2363 / 50 FEB 6 '57 CO DD 2274  
FU 150' oil 12 hrs DD FEB 13 '57  
DD 2378 FYBC & Ld. FEB 27 '57  
est P. 20 Bopd + 15  
BWpd