


Section 33 Township 18 Range 43

Well No. #1 Holub "A"

Company Ketner & Rhodes

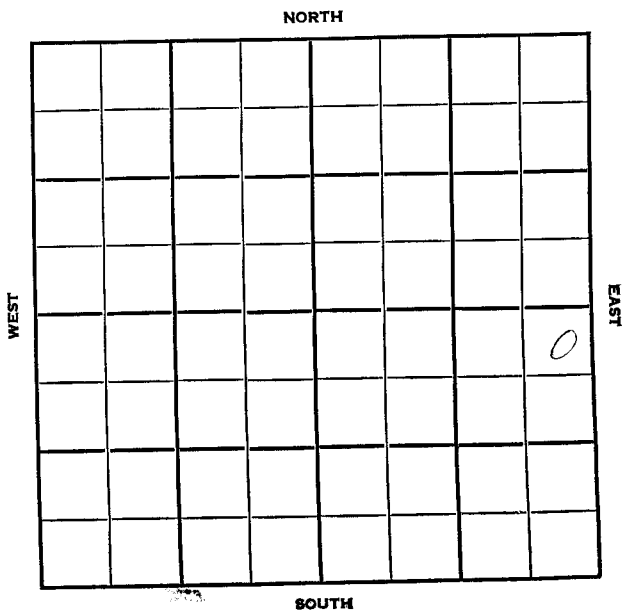

County Mason Elev. \_\_\_\_\_  
 Sec. 33 Twp. 18 Rge. 4E  
 Company Ketner & Rhodes  
 Farm Name Holub "A" No. 1

TOPS	DEPTH	LOG	DATUM	Loc. in Sec.
Anh.				NE NE SE
Tp.				
H.				
Tr.				
Dg.				
Bl.				
L.				Geol. _____
K.C.				Cont. _____
B.K.C.				Sunflower Tools
Ce.				
C.				
M.				Pool
M.				Antelope
K.				
Mz.				
Mo.				
V.				
S.				
S.				
A.				
R.				
PE.				
G.				
TD.				

FIRST REPORT  
 NOV 21 1956

Date Comm. spd. 11-17-56  
8" @ 225, Drlg. 555

\_\_\_\_\_  
 \_\_\_\_\_  
 \_\_\_\_\_  
 \_\_\_\_\_  
 \_\_\_\_\_  
 \_\_\_\_\_  
 \_\_\_\_\_

Co.  
 No.  
 Sec.  
 I.  
 R.

County Marion Elev. 1401  
1415 DF  
 Sec. 33 Twp. 18 Rge. 4E  
 Company Ketner & Rhodes  
 Farm Name Holub "A" No. 1

TOPS	DEPTH	LOG	DATUM
Anh.			
Tp.			
H.			
Tr.			
Dg.			
Bl.			
L.			
K.C.			
B.K.C.			
Ce.			
C.	<u>2337</u>		
M.	<u>2326</u>		
M.	<u>2358</u>		
K.			
Mz.			
Me.			
V.			
S.			
S.			
A.			
R.			
Pe.			
G.			
TD	<u>2368</u>	<u>2336</u>	

Loc. in Sec. NE NE SE  
400 FNL  
250 FEL OF SE 4  
 Geol. \_\_\_\_\_  
 Contr. Sunflower Tool  
 Pool Antelope  
 COMPLETE  
 JAN 2 '57

Date Comm. spd. 11-17-56  
8" @ 225, Drlg. 555 NOV 28 '56  
2364 5 1/2 ~~2331~~  
WOCF DEC 5 '56 DEC 12 '56 DD 2377  
150' RU + 490' wt 12 hrs TO  
Frac. DEC 12 '56 DEC 20 '56 POT P. Ld.  
JAN 2 '57 est P. 15 BOPd + 135  
Bwpd.

Co.  
 No.  
 Sec.  
 T.  
 R.