



Sec. 33 Twp. 18 R. 4-E

Well No. 1 Sklenar Farm


I. F. Leeker Company

Antelope Pool  
330 Ft. from N. Line

\_\_\_\_\_ Ft. from S. Line

990 Ft. from E. Line

\_\_\_\_\_ Ft. from W. Line

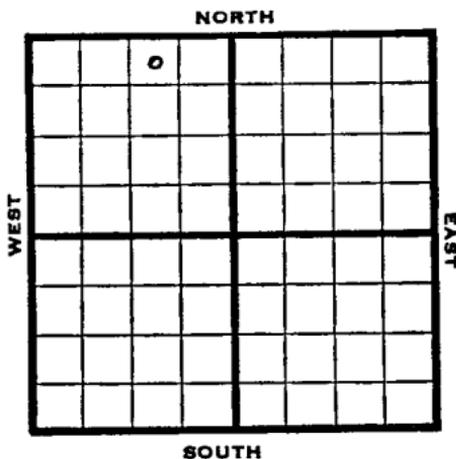

NW NE NW

1947 Elev. 1446 REPORT

- 9/3 Machine
- 9/10 12" @ 105'  
Drlg. 530'
- 9/17 10" @ 809'  
Drlg. 1135'
- 9/24 8" @ 1426'  
Drlg. 1460'
- 10/1 KC 1837'  
6" @ 1849' SO
- 10/8 TD 1860'  
3000 acid  
Swb 1 oil PH, 17 hrs.
- 10/15 Swb 130 oil in 17 hrs.
- 10/22 "
- 10/29 KC 1847'  
6" @ 1846½  
Pump 20 oil SW  
Pot  
TD 1870'  
Gravity 33

**COMPLETE**

Kansas

Map No. \_\_\_\_\_ Sec. 33 Twp. 18 R. 4E

Well No. 1 Sklënar

I. F. Leeker Company

FIRST REPORT

Contractor

NEW NEW NEW

SECTION PLAT

330 Ft. from N. Line

\_\_\_\_\_ Ft. from S. Line

990 Ft. from E. Line

\_\_\_\_\_ Ft. from W. Line

	0		

Marion County

Location \_\_\_\_\_

Rig up \_\_\_\_\_

Drilling and Remarks:

Machine \_\_\_\_\_

RECORD

Cased \_\_\_\_\_ in., \_\_\_\_\_ ft.

Sand \_\_\_\_\_

Gas \_\_\_\_\_

Oil \_\_\_\_\_

Total Depth \_\_\_\_\_

PRODUCTION

1st 24 hrs. Nat. \_\_\_\_\_

1st 24 hrs. after shot \_\_\_\_\_

Gas \_\_\_\_\_ Cu. Ft.

Dry Hole \_\_\_\_\_

Abandoned \_\_\_\_\_

Date

SEP 3 1947 19

S. J. LEWIS Scout

Map No. 26 Sec. 33 Twp. 18 R. 4E

Well No. 1 Sklenar

I. F. Lieker Company

COMPLETE Contractor

NW NE NW

E. 11446  
SECTION PLAT

330 Ft. from N. Line

\_\_\_\_\_ Ft. from S. Line

990 Ft. from E. Line

\_\_\_\_\_ Ft. from W. Line

	0		

Marion County

Location \_\_\_\_\_

Rig up \_\_\_\_\_

Drilling and Remarks:

*KC 1547*

*6" C/A + 1/2*

*Run 2006 NW*

*OK*

*33 2/4*

RECORD

Cased \_\_\_\_\_ in., \_\_\_\_\_ ft.

Sand \_\_\_\_\_

Gas \_\_\_\_\_

Oil \_\_\_\_\_

Total Depth 1875

PRODUCTION

1st 24 hrs. Nat. \_\_\_\_\_

1st 24 hrs. after shot \_\_\_\_\_

Gas \_\_\_\_\_ Cu. Ft.

Dry Hole \_\_\_\_\_

Abandoned \_\_\_\_\_

Date

OCT 29 1947 19

S. J. LEWIS Scout