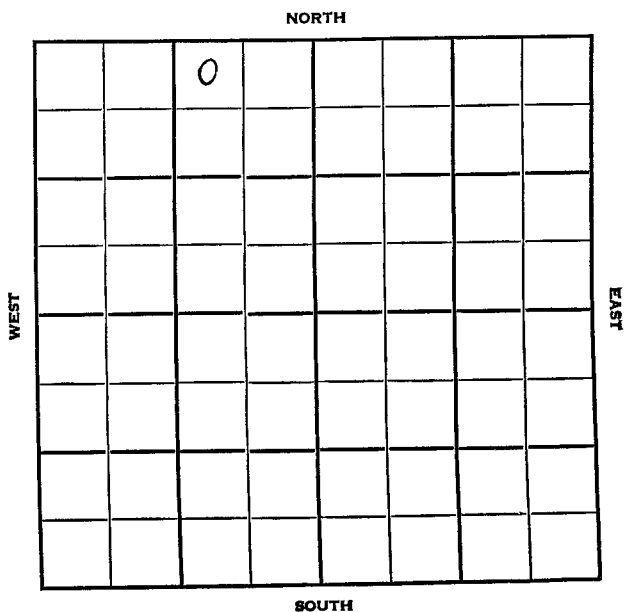


Section 33 Township 18 Range 4 EWell No. # 2 SklenarCompany Harvey Elton

Marion KANSAS

SEC.	TWP.	R.
33	18	4E

WELL NO.

2 Sklenar

FARM

COMPANY

Harvey Elton

CONTRACTOR

Berentz

N. Antelope Pool


330 Ft. from N. Line

Ft. from S. Line

990 Ft. from E. Line

Ft. from W. Line

NW NE NW

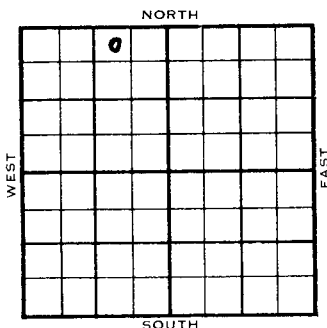

1954

ELEVATION
1447'

REPORT

10/20

Spud 10-18-54
8" @ 89'
KC 1837'
Drlg. 2060'

11/3

Spud 10-18-54
Oil Well
TD 2435'
8" @ 89'
KC 1837', Miss 2393'
FU 100' oil 1700' wtr. 14 hr
TD 2394'
4" @ 2394'
DD 2435'
S/ 4 bo 95 bw 4 hr.
Comp 20 bopd. 150 bw.

COMPLETED

County Marion State Kansas

Sec. 33 (Blk.) 18 (Sur.) 4E Map No.

Operator Harvey Elton

Well No. 2 Farm Sklenar

Elev. 1447 Location NW NW NW

		0			

330 Ft. From N Line NW

990 Ft. From E Line Quarter

1st. Report

Completion NOV 3 1954

Remarks N. Antelope Pool

Berentz- Contr.

Spudding Date 10-18-54

Drig. Data Oil well TD 2435

8" C 89 KC 1837 Miss. 2393 TD 2394

4" C 2394 DD 2435 FU 100' oil 1700' wtr.

14 hr. S/ 4 bo 95 bw 4 hr.

Comp. 20 bopd 150 bw

FABEN GILSTRAP