


Marion

KANSAS

SECTION 33 TOWNSHIP 18 RANGE 4E

WELL NO. #1 Sklenar (SWD)

COMPANY Harvey Elton, etal

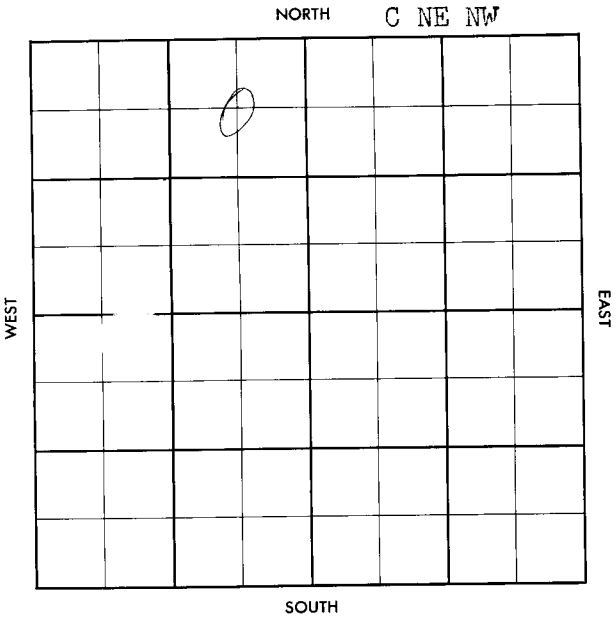

County Marion Elev. 1442 DF  
 Sec. 33 Twp. 18 Rge. 4E  
 Company Harvey Elton et al  
 Farm Name Sklenar (SND) No. 1

TOPS	DEPTH	LOG	DATUM
Anh.			
Tp.			
H.			
Tr.			
Dg.			
Bl.			
L.			
K.C.	1829		
B.K.C.			
Ce.			
C.			
M.			
M.			
K.			
Mz.			
Ma.			
V.			
S.			
S.			
A.			
R.			
PE.			
G.			
TD	RTD	2000	

Loc. in Sec. C NE NW  
twin - 80'  
E of #1  
 Geol. \_\_\_\_\_  
 Contr. \_\_\_\_\_  
Ola Berentz  
 Pool \_\_\_\_\_  
Antelope No.

FIRST REPORT			
MAR 27 '57			

Date Comm. 3-20-57  
8" @ 215, 4" @ 1985, to CO & acidize

Co. No. Sec. T. R.

County Marion Elev. 1442 DF  
 Sec. 33 Twp. 18 Rge. 4E  
 Company Harvey Elton et al  
 Farm Name Skienar (Sk.D) No. 1

TOPS	DEPTH	LOG	DATUM
Anh			
Tr.			
H.			
Tr.			
Dg.			
Bl.			
L.			
K.C.	1829		
B.K.C.			
Ce.			
C.			
M.			
M.			
K.			
Me.			
Mo.			
V.			
S.			
S.			
A.			
R.			
PE.			
G.			
T.D.	RTD	2000	

Loc. in Sec. C NE NW  
twin - 80'  
E of #1  
 Geol. \_\_\_\_\_  
 Contr. \_\_\_\_\_  
Ola Berentz  
 Pool \_\_\_\_\_  
 Antelope No. \_\_\_\_\_

APR 17 '57  
**ABANDONED**

Date Comm. 3-20-57  
8" @ 215, 1" @ 1985, to CO & acidize  
APR 12 '57 APR 17 '57 CO 2000 1 1/2  
complete for SWP well

Co.  
No.  
Sec.  
T.  
R.