

Marion

KANSAS

33


18

4E

SECTION _____ TOWNSHIP _____ RANGE _____

WELL NO. #1 Musterman

COMPANY Prairie Oil & Gas

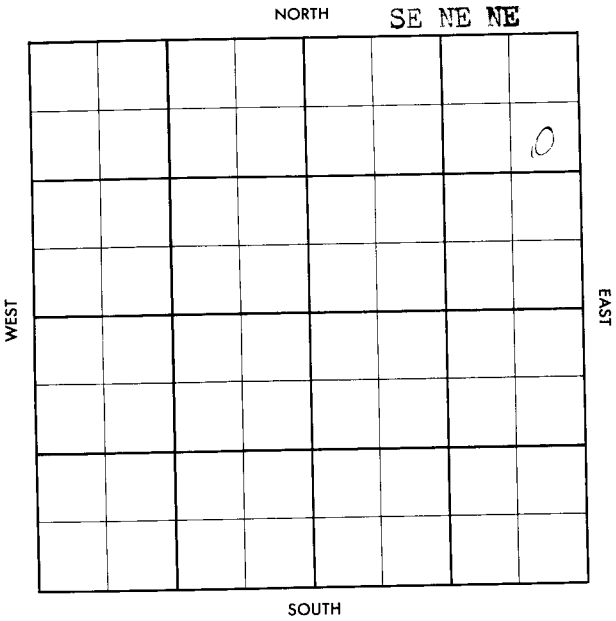

County Marion Elev. 1405 DF
 Sec. 33 Twp. 18 Rge. 4E
 Company Prarie Oil & Gas
 Farm Name Misterman No. 1

TOPS	DEPTH	LOG	DATUM	Loc. in Sec.
Ans.				SE NE NE
Tr.				
H.				
Tr.				
Dg.				
Bl.				
L.				Geol.
K.C.				Contr.
BXC.				Co. Tools
Ce.				Pool
C.				Antelope
M.	2332			
M.				
K.				
Mz.				
Ma.				
V.				
S.				
S.				
A.				
R.				
Pe.				
G.				
TD	2354			FIRST REPORT

Date Comm. 2-26-57

8" @ 187/150, 4" @ 2347/80

70

County Marion Elev. 1405 DF
 Sec. 33 Twp. 18 Rge. 4E
 Company Prairie Oil & Gas
 Farm Name Musterman No. 1

TOPS	DEPTH	LOG	DATUM	Loc. in Sec.
Ant.				SE NE NE
Tp.				
H.				
Tr.				
Dg.				
Bl.				
L.				Geol.
K.C.				Contr.
B.K.C.				Co. Tools
Ce.				Pool
C.				Antelope
M.				
M.	2332			
K.				
Mz.				
Ma.				
V.				
S.				
S.				
A.				
R.				
Pe.				
G.				
TD	2354			COMPLETE

Date Comm. 2-26-57

8" @ 187/150, 4" @ 2347/80 407-13-57 CO TO

1/4 BOPM Net Frac 10/10 b/l

S 160 BNO TYR MAR 20 57 EST

P. 25 Bopd + 75 Bwpd