


KANSAS

Marion

Section 34 Township 18 Range 2E

Well No. 1 Scully

Company Anderson-Prichard
Misc.

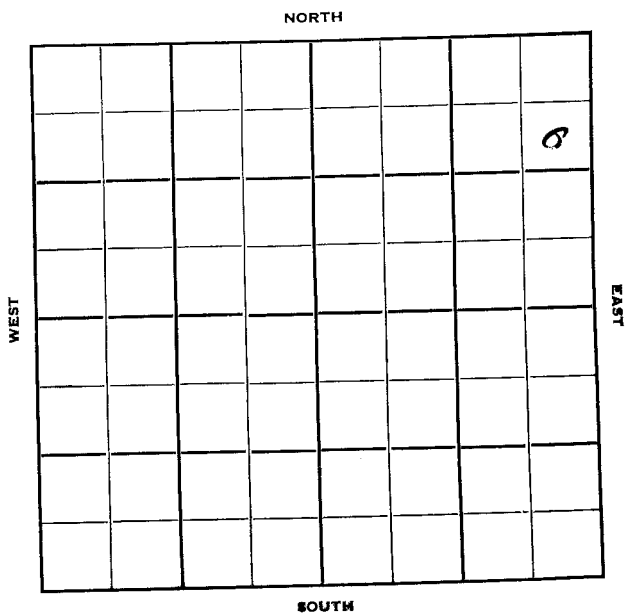

KANSAS

Marion ✓

Sec. 34 Twp. 18 R. 2E

Well No. 1 Scully Farm

Anderson-Prichard Company


Misc.

990 Ft. from N. Line

Ft. from S. Line

330 Ft. from E. Line

Ft. from W. Line

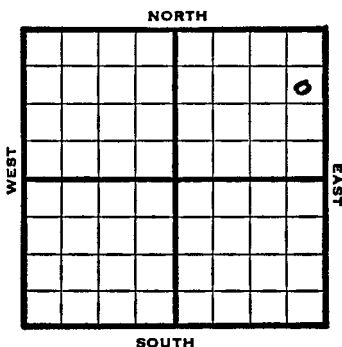

SE NE NE

1949 Elev 1374' REPORT

9/28 Loc.
10/5 8" @ 160'
Drlg 1700'
10/12 Miss 2512'
Drlg 2792'
10/19 Viola 2923'
Simpson 3000'
TD 3017'
5" @ 3005'
HFW
10/26 Viola 2923'
TD 3017'

2923
2512
411

ABANDONED

Map No. _____ Sec. 34 Twp. 18 R. 2E

Well No. 1 Scully

Andersen-Prichard Company

SE NE 1/4


FIRST REPORT
SECTION PLAT

990 Ft. from N. Line

Ft. from S. Line

330 Ft. from E. Line

Ft. from W. Line

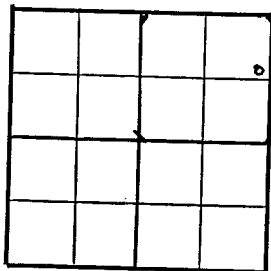

Marion County

Location X

Rig up

Drilling and Remarks:

RECORD

Cased _____ in., _____ ft.

Sand _____

Gas _____

Oil _____

Total Depth _____

PRODUCTION

1st 24 hrs. Net _____

1st 24 hrs. after shot _____

Gas _____ Cu. Ft.

Dry Hole _____

Abandoned _____

Date

SEP 28 1949

19

S. J. LEWIS

Scout

Kansas

Miscellaneous

Map No. _____ Sec. 34 Twp. 18 R. 2EWell No. 1 Scully

Anderson-Prichard

Company

ABANDONED

Contractor


SE NE NE

E11374
SECTION PLAT990 Ft. from N. Line

_____ Ft. from S. Line

330 Ft. from E. Line

_____ Ft. from W. Line

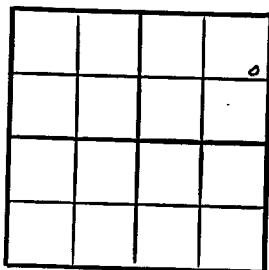

Marion County

Location _____

Rig up _____

Drilling and Remarks:

Water 2823

RECORD

Cased _____ in., _____ ft.

Sand _____

Gas _____

Oil _____

Total Depth 2812

PRODUCTION

1st 24 hrs. Nat. _____

1st 24 hrs. after shot _____

Gas _____ Cu. Ft.

Dry Hole _____

Abandoned _____

Date

OCT 28

19

S. J. LEWIS

Scout