


Section 34 Township 18 Range 2E

Well No. #4 Scully

Company Anderson-Prichard

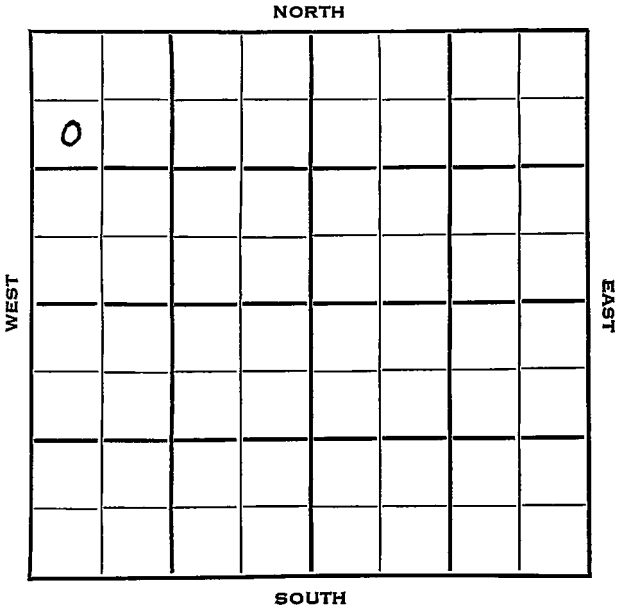

Sec. 34 Twp. 18 R. 2E

Well No. #1 Scully Farm

Anderson-Prichard

Company

Glenn Peel

Contractor

Durham Pool


990 Ft. from N. Line

_____ Ft. from S. Line

_____ Ft. from E. Line

330 Ft. from W. Line

SW NW NW

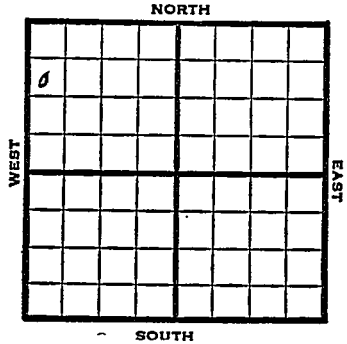

1953

Elev. 1365' REPORT

4/29

Spud 4-25-53
8" @ 157'

6/3

Drlg 2035'
 Spud 4-25-53 Oil well TD 2914'
 8" @ 157 Heeb 1701 Lans 1917
 Miss 2494 Kh. 2663 Meisener 2910
 Viola 2912
 DST 2909-14 open 1 hr rec 115' oil,
 40' HOCM 1065# TD 2914 5" @ 2912'
 CO to 2914' S/2 $\frac{1}{2}$ BOPH 2% wtr. 2% BS
 P/56 BO 4 BWPD
 Comp. 146 BOPD 7% wtr.

COMPLETED

County Marion State Kansas
 Sec. 34 (Blk.) 18 (Sur.) 2E Map No. (Twp.) (Rge.)
 Operator Anderson-Prichard
 Well No. 4 Farm Scully
 Elev. 1365 Location SW NW NW

0					

990 Ft. From N Line NW330 Ft. From W Line Quarter

1st. Report

Completion JUN 3 1953Remarks Durham PoolGlenn Peel - Contr.Spudding Date 4-25-53Drlg. Data Oil well TD 29148" @ 157 Heeb. 1701 Lans. 1917Miss. 2494 Kh. 2663 Meisener 2910Viola 2912 DST 2909-14 open 1 hr.Rec. 115' oil 40' hocm 1065#TD 2914 5" @ 2912 CC to 2914S/ 2 $\frac{1}{2}$ boph 2% wtr. 2% bsP/ 56 bo 4 bwpdComp. 146 bopd 7% wtr.

J. G. McGEHEE

County Marion State KansasSec. 34 (Blk.) 18 (Sur.) 2E (Twp.) 18 (Rge.) 2E Map No.Operator Anderson-PrichardWell No. 4 Farm ScullyElev. _____ Location SW NW NW

0							

990Ft. From N Line NW330Ft. From W Line Quarter1st. Report APR 29 1953

Completion _____

Remarks _____

Glenn Peel - Contr.Spudding Date 4-25-53Drlg. Data Durham Pool8" @ 157 drlg. 2035