

Marion


KANSAS

SECTION 35 TOWNSHIP 18S RANGE 2E

WELL NO. #1 Scully

COMPANY Frank Deiter

NORTH NW SW NW

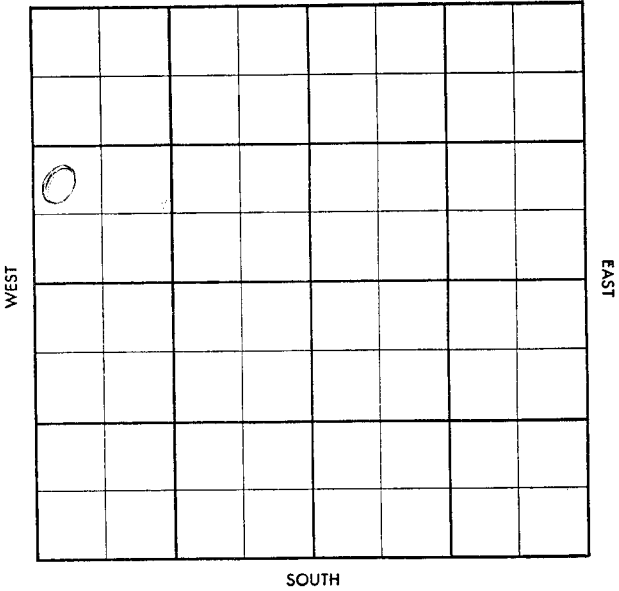

~~Top~~ ~~Foot~~
~~...~~ ~~...~~

S-513-B

County Marion Elev. _____
 Sec. 35 Twp. 18 Rge. 2E
 Company Frank Deiter
 Farm Name Scully No. 1


TOPS	DEPTH	LOG	DATUM
Anh.			
Tp.			
H.			
Tr.			
Dg.			
B.L.			
L.			
K.C.			
B.K.C.			
Ce.			
C.			
M.			
M.			
K.			
Mz.			
Mq.			
V.			
S.			
S.			
A.			
R.			
Pf.			
G.			
T.D.			

Loc. in Sec. NW SW NW

Geol. Bob Wall

Contr. _____
Slusser Drlg.

Pool _____
Durham

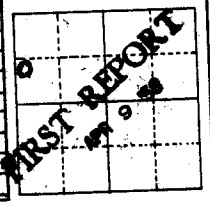

Date Comm. 4/4/58
8" @ 152, Drlg. 2124.

Co.

158

No.

Sec.

1.

22

~~Top X~~
~~Bottom X~~

S-513-B

County Marion Elev. 1377 DF
 Sec. 35 Twp. 18 Rge. 2E
 Company Frank Deiter
 Farm Name Scully No. 1

TOPS	DEPTH	LOG	DATUM
Anh.			
Tp.			
H.			
Tr.			
Dg.			
B.L.			
L.			
K.C.			
B.K.C.			
Ce.			
C.			
M. <u>Chart</u>	<u>2523</u>		
M.			
K.	<u>2680</u>		
Mz.	<u>2930</u>		
Mq.			
V.	<u>2931</u>		
S.			
S.			
A.			
R.			
Pf.			
G.			
T.D.	<u>2934</u>		

Loc. in Sec. NW SW NW
 Geol. Bob Wall
 Contr. Slusser Drlg.

Pool Durham

ABANDONED
 APR 16 58

Date Comm. 4/4/58
8" @ 152, Drlg. 2124. APR 15 58 DST 2920
-34 op/hr - 900' sulphur w 50 FP
-15 -390 BHP 1015720 m 149

D6A

Co.
Lse.
No.
Sec.
T.
R.