


DX 78-1 Marion

KANSAS

Section 4 Township 18 Range 4E

Well No. #4⁵ Jirak

Company Ward McGinnis

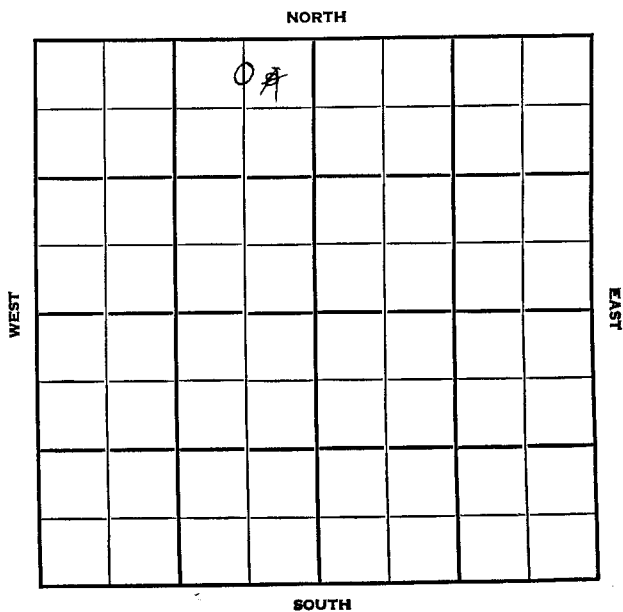

Marion

KANSAS

SEC.	TWP.	R.
4	18	4E

WELL NO.

#5 Jirak

FARM

COMPANY

Ward McGinnis

CONTRACTOR

Co. Tools

Wildcat.

330

Ft. from N. Line


Ft. from S. Line

330-660

Ft. from E. Line

Ft. from W. Line

C N 2

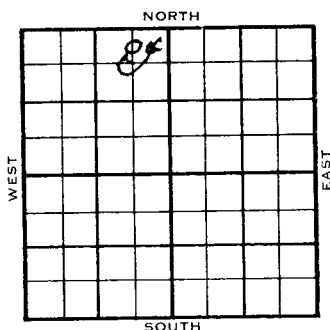~~NE~~ NE NW

1954

ELEVATION
1477'

REPORT

11/17

Spud 11-14-54

8" @ 115'

Drlg. 664'

12/15

Spud 11-14-54

Oil Well

TD 2384'

8" @ 115'

KC 1847' Miss 2380'

TD 2384'

5" @ 2380'

DP to 2384'

15 go 1 hr. sd-oil-frac.

Comp 5 bopd.

COMPLETED

County Marion State Kansas

Sec. 4 (Blk. Twp.) 18 (Sur. Rge.) 4E Map No.

Operator Ward McGinnis

Well No. 5 Farm Jirak

Elev. 1477 Location C N $\frac{1}{2}$ NE NW

0

COMPLETE

330 Ft. From N Line NW

660 Ft. From E Line Quarter

1st. Report

Completion DEC 15 1957

Remarks Wildcat

Co. tools

Spudding Date 11-14-54

Drig. Data Oil well TD 2384

8" @ 115 KC 1847 Miss. 2380

TD 2384 5" @ 2380 DP to 2384

15 go 1 hr. sd-oil-frac

Comp. 5 bopd

Kansas

Map No. _____ Sec. 4 Twp. 18 R. 4EWell No. 5 Jirak

_____ Ward McGinnis _____ Company

_____ CORRECTION _____ Contractor

C $N\frac{1}{2}$ NE NW

SECTION PLAT

330 Ft. from N. Line

_____ Ft. from S. Line

660 Ft. from E. Line

_____ Ft. from W. Line

	o		

Marion County

Location _____

Rig up _____

Drilling and Remarks:

Reported

NE NE NW

RECORD

Cased _____ in., _____ ft.

Sand _____

Gas _____

Oil _____

Total Depth _____

PRODUCTION

1st 24 hrs. Nat. _____

1st 24 hrs. after shot _____

Gas _____ Cu. Ft.

Dry Hole _____

Abandoned _____

Date

Dec 15 1954 19 _____ Scout