

State Geological Survey
WICHITA, BRANCH

KANSAS DRILLERS LOG

15-115-20299

API No. 15 — 115 — 20,299
County Number

S. 19 T. 18 R. 5 E
W
Loc. 2240' FEL & 1200' FSL

County Marion

Operator
R. L. Burns Corp.

Address
Box 277 Marion, Kansas


Well No. # 1 Lease Name Svoboda

Footage Location
1270 feet from (N) (S) line 2210 feet from (E) (W) line

Principal Contractor Kan Go, Inc. Geologist Frank S. Mize

Spud Date 10-22-76 Total Depth 2531 P.B.T.D. 2270

Date Completed Oil Purchaser Summit

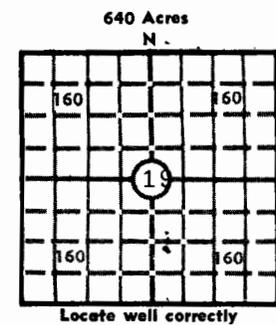

Locate well correctly
Elev.: Gr. 1427

DF KB 1437

CASING RECORD

Report of all strings set — surface, intermediate, production, etc.

Purpose of string	Size hole drilled	Size casing set (in O.D.)	Weight lbs/ft.	Setting depth	Type cement	Sacks	Type and percent additives
surface pipe	12 1/4	8 5/8	28	199	Class A	150	3% cacl
production pipe	7 7/8	4 1/2	9 1/2	2512	Class A	150	3% cacl

LINER RECORD

PERFORATION RECORD

Top, ft.	Bottom, ft.	Sacks cement	Shots per ft.	Size & type	Depth interval
			1	3 1/8 D.P.	2216-30
TUBING RECORD			1	1 1/8 D.P.	2236-40
Size	Setting depth	Packer set at			

ACID, FRACTURE, SHOT, CEMENT SQUEEZE RECORD

Amount and kind of material used	Depth interval treated
20,000 gal. nitroflied gelled frac fluid, 20,000# 20-40 sand;	Intervals perfed
20,000 # 10-20 sand; flush with 21,000 scf N ₂	

INITIAL PRODUCTION

Date of first production <u>2-26-77</u>	Producing method (flowing, pumping, gas lift, etc.) <u>Flowing</u>			
RATE OF PRODUCTION PER 24 HOURS	Oil bbls.	Gas <u>250</u> MCF	Water <u>0</u> bbls.	Gas-oil ratio CFPB
Disposition of gas (vented, used on lease or sold) <u>sold</u>		Producing interval(s) <u>Mississippi Chat</u>		

INSTRUCTIONS: As provided in KCC Rule 82-2-125, within 90 days after completion of a well, one completed copy of this Drillers Log shall be transmitted to the State Geological Survey of Kansas, 4150 Monroe Street, Wichita, Kansas 67209. Copies of this form are available from the Conservation Division, State Corporation Commission, 3830 So. Meridian (P.O. Box 17027), Wichita, Kansas 66217. Phone AC 316-522-2206. If confidential custody is desired, please note Rule 82-2-125. Drillers Logs will be on an open file in the Oil and Gas Division, State Geological Survey of Kansas, Lawrence, Kansas 66044.

erator

R. L. Burns

DESIGNATE TYPE OF COMP.: OIL, GAS, DRY HOLE, SWDW, ETC.:

Well No.

1

Lease Name

G. Svoboda

S 19 T 18 R 5 ^E_W

WELL LOG

Show all important zones of porosity and contents thereof; cored intervals, and all drill-stem tests, including depth interval tested, cushion used, time tool open, flowing and shut-in pressures, and recoveries.

SHOW GEOLOGICAL MARKERS, LOGS RUN, OR OTHER DESCRIPTIVE INFORMATION.

FORMATION DESCRIPTION, CONTENTS, ETC.	TOP	BOTTOM	NAME	DEPTH

USE ADDITIONAL SHEETS, IF NECESSARY, TO COMPLETE WELL RECORD.

Date Received

Frank S. Szyed
Signature

GEOLOGIST
Title

3-22-77
Date

15-115-20299

WICHITA BRANCH
APR 15 1976

19-18-5E

STATE	KANSAS	11-2-78	MAP NO.	S-T-R	19-18S-5E	D
OPER	R. L. BURNS CORP			SPOT	APP W/2 W/2SE	INT
	BOX 277, MARION, KS			CO	MARION	SUS
WELL	1 SVOBODA (G)			ELEV.	1425 TS	FIN
CONTR	KAN-GO			2240' fsl, 1270' fsl of Sec 19		
FIELD	LOST SPRINGS (KC-MISS)			TOPS NOT AVAIL		
IP	OPERATIONS SUSPENDED			RTD EST -2500 - 1076		
	API 15-115-20299			TD IN MISS Mg 2531 - 1094		

SPUD 10-22-76,
RTD Est 2500, Pipe Set
OPERATIONS SUSPENDED 10-26-76

8 5/8 - 199
4 1/2 - 2512

K.B. 1937
G.L. 1927

L. TOPS

GED FRANK MIZE

Ireland 1566 - 129
L 1710 - 273
Mch 2216 - 779
M/m 2246 - 809
Kh 2272 - 835
H 2450 - 1013
Mg 2488 - 1051
RTD 2531 - 1094
PBTD 2270

RAN IEL, LND LOGS
PERF 2216-30/4
2236-40/4
FRAL w/20,000 gals
NITROFLO GELLED FLUID #40,000 sd
FLUSH w/ 21,000 scf N₂

COMP ISSUED 11-8-76

 Petroleum Information Corporation
COPYRIGHTED 1976. REPRODUCTION PROHIBITED