


Section 9 Township 18 Range 4E

Well No. #1 Fresta

Company Frank Vieter

Lost Spring Pool NORTH

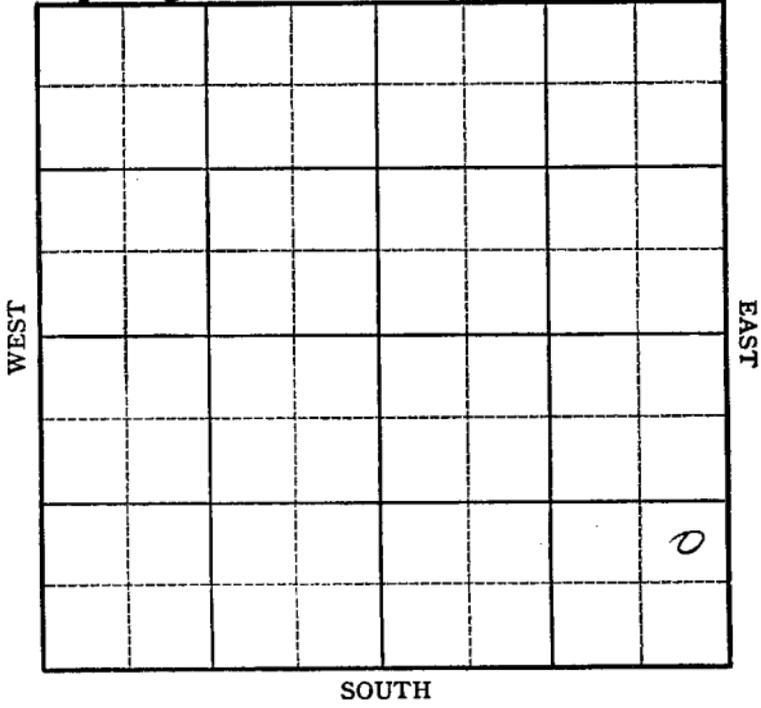

Marion

KANSAS

Sec. 9 Twp. 18 R. 4E

Well No. #1 Franta Farm

Frank Vieter Company

Lost Spring (Slusser, Contr.) NORTH
Pool


Ft. from N. Line

990' Ft. from S. Line

330' Ft. from E. Line

Ft. from W. Line

NE SE SE

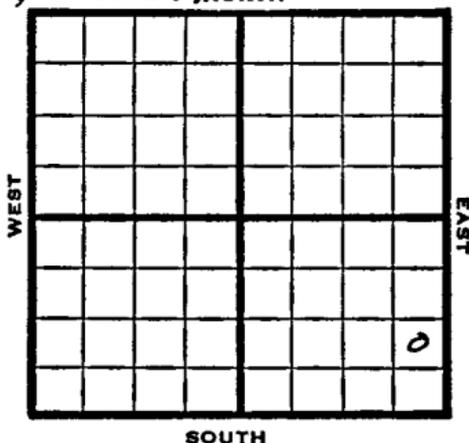

1949 Elev 1453' REPORT

12/21 Drlg. 30'
2/28 8" @ 95'
Drlg 1920'

.950
1/29 TD 2414'
8" @ 95'
TD 2414'
P 2 1/2 BOPD
Comp

COMPLETED

Kansas

Lost Spring Po

Map No. _____ Sec. 9 Twp. 18 R. 4EWell No. 1 Franta

_____ Frank Vieter _____ Company

_____ Slusser _____ Contractor

NE SE SE

FIRST REPORT
SECTION PLAT

			o

_____ Ft. from N. Line

990 Ft. from S. Line330 Ft. from E. Line

_____ Ft. from W. Line

Marion County

Location _____

Rig up _____

Drilling and Remarks:

drlg. 30

RECORD

Cased _____ in., _____ ft.

Sand _____

Gas _____

Oil _____

Total Depth _____

PRODUCTION

1st 24 hrs. Nat. _____

1st 24 hrs. after shot _____

Gas _____ Cu. Ft.

Dry Hole _____

Abandoned _____

Date

DEC 21 1949 19S. J. LEWIS Scout

Kansas

Map No. _____ Sec. 9 Twp. 18 R. 4EWell No. 1 Franta

_____ Frank Dieter _____ Company

Contractor


NE SE SE

E. 1453
SECTION PLAT

_____ Ft. from N. Line

990 Ft. from S. Line330 Ft. from E. Line

_____ Ft. from W. Line

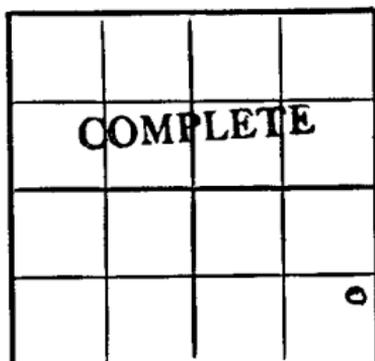

Marion County

Location _____

Rig up _____

Drilling and Remarks:

8' @ 95T.D. 2414P 2 1/2 BOPDC

RECORD

Cased _____ in., _____ ft.

Sand _____

Gas _____

Oil _____

Total Depth 2414

PRODUCTION

1st 24 hrs. Nat. _____

1st 24 hrs. after shot _____

Gas _____ Cu. Ft.

Dry Hole _____

Abandoned _____

Date

MAR 29 1950

19

J. E. TYRA

Scout