


Marion
Form 51-5M-2-29-34703

Map No. KANSAS Sec. 1 Twp. 19 R. 2 E
Well No. 1-B Sully Farm
Empire Oil Co. Company

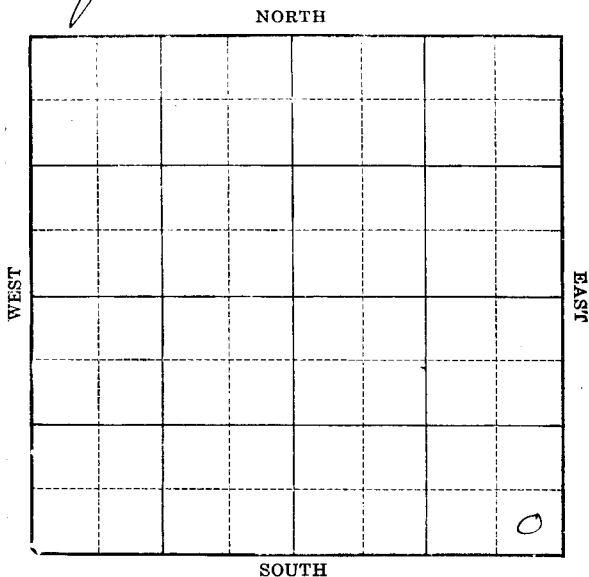

Location _____
Drilling Remarks _____

RECORD

Cased _____ in. _____ ft.
Sand _____
Gas _____
Oil _____
Total Depth _____

Rig Up _____
Drilling Remarks _____

PRODUCTION

1st 24 hrs. Nat. _____
1st 24 hrs. after shot _____
Gas _____ cu. ft. _____
Dry Hole _____
Abandoned _____


Map No. KANSAS Sec. 1 Twp. 19 R. 2E
Well No. 1-B. Scully Farm
Empire Oil Co Company

_____ Ft. from N. Line

330 Ft. from S. Line

330 Ft. from E. Line

_____ Ft. from W. Line

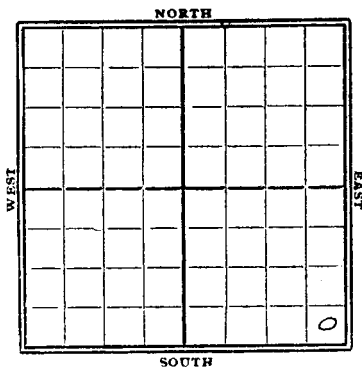

1929

Date	REPORT
4/2	Location
4/10	—
4/17	—
4/24	—
5/1	—
5/8	—
5/15	—
5/22	—
5/29	Timbers
6/5	65 bdy
6/12	65 bdy
6/19	Wdly 890'
6/26	" 1190'
7/2	" 1670'
7/10	Wdly 8"- 1820'
7/17	Wdly 1943'
7/24	" 2231'
7/31	Top chat 2439' 2468'
	SD 2443'
8/7	Top chat 2468'
	HFV 2470-75'
	Wdly 2543'

8/14- Top Viola 2838,
show oil 2846
HFW 2854'
SID. 2861'

8/21- Top Viola 2838,
show oil 2846'
TD 2861'- HFW
Abandoned

Map No. **KANSAS** Sec. 1 Twp. 19 R. 2E

Well No. 24 1 B. Scully

Empire Oil & Ref. Company

Contractor

SECTION PLAT

			0

.....Ft. from N. Line

020 Ft. from S. Line

030 Ft. from E. Line

.....Ft. from W. Line

Location.....✓

Rig up.....

Drilling and Remarks:

RECORD

Cased.....in.,ft.

Sand.....

Gas.....

Oil.....

Total Depth.....

PRODUCTION

1st 24 hrs. Nat.....

1st 24 hrs. after shot.....

Gas.....Cu. Ft.

Dry Hole.....

Abandoned.....

Date

APR 8 1929

S. J. LEWIS

Scout

24 KANSAS

Map No. 1 Sec. 1 Twp. 19 R. 2

Well No. 1 B Scully

Empire Company

Contractor

COMPLETE

SECTION PLAT

			0

Ft. from N. Line

330 Ft. from S. Line

330 Ft. from E. Line

Ft. from W. Line

ABANDONED

Location

Rig up

Drilling and Remarks;

Top made 7838
Show oil 7846

RECORD

Cased in., ft.

Sand

Gas

Oil

Total Depth 2861 #

PRODUCTION

1st 24 hrs. Nat.

1st 24 hrs. after shot

Gas Cu. Ft.

Dry Hole ✓

Abandoned ✓

Date

8/21

1929

CHAS. L. SHERWOOD

Scout