

Marion


KANSAS

SECTION 1 TOWNSHIP 19S RANGE 4E

WELL NO. #2 Wight "B"

COMPANY John T. Hannah + Newton

NORTH ~~NE NE NE~~
~~SE SE NW~~

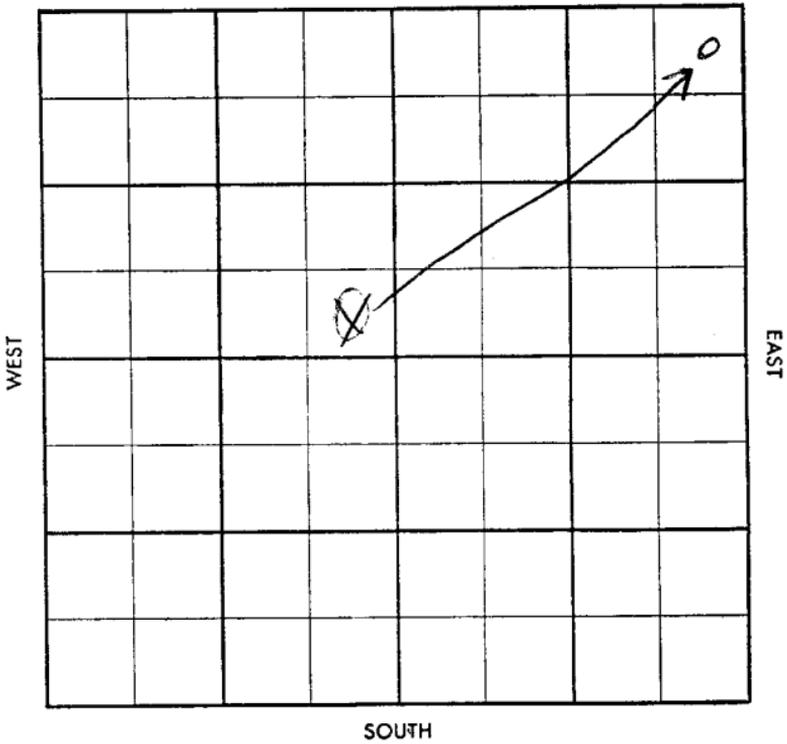

~~DX~~

County Marion Elev. _____

Sec. 1 Twp. 19 Rge. 4E

Company John T. Hannah

Farm Name Wight No. 2

TOPS	DEPTH	LOG	DATUM
Anh.			
Tp.			
H.			
Tr.			
Dg.			
B.L.			
L.			
K.C.			
B.K.C.			
Ce.			
C.			
M.			
M.			
K.			
Mz.			
Mq.			
V.			
S.			
S.			
A.			
R.			
Pf.			
G.			
T.D.			

Loc. in Sec. SE SE NW

Geol. _____

Contr. Midwest tools

Pool Antelope SE

FIRST REPORT

MAR 5 '98

Date Comm. _____

Location _____

Co.

No.

Sec.

T.

R.

CORRECTION

WP. Pool
 Co. Facet

S-513-B

County Marion Elev. 1457 DF 14608
 Sec. 1 Twp. 19 Rge. 4E
 Company John T. Hannah & Newton
 Farm Name Wight ~~"B"~~ No. 22X

TOPS	DEPTH	LOG	DATUM
Anh.			
Tp.			
H.			
Tr.			
Dg.			
B.L.			
L.			
K.C.			
B.K.C.			
Ce.			
C.			
M. Chat <u>2334</u>			
M. <u>Chat</u> <u>2315</u>			
K.			
Mz.			
Mq.			
V.			
S.			
S.			
A.			
R.			
Pf.			
G.			
I.D. <u>2321</u> 2324			

Loc. in Sec. SE SE NW
ne ne ne
 Geol. _____
 Contr. _____
Midwest tools
 Pool _____
Antelope SE
COMPLETE
 JUN 18 '58

Date Comm. 3-18-58 8" 95
 Location MAR 12 '58 MAR 19 '58 MAR 26 '58 01900
APR 2 '58 4 1/2 2334 W O C T APR 9 '58
APR 10 '58 APR 23 '58 CO APR 30 '58 2329 20gts
nitro free MAY 7 '58 MAY 14 '58 MAY 21 '58 see
Ld W O P U MAY 24 '58 JUN 1 '58 JUN 18 '58
P25 Bood + W