

Marion

KANSAS


SECTION 1 TOWNSHIP 19S RANGE 4E

WELL NO. #1 Lucille Wight

COMPANY John T. Hannah

NORTH

^C
~~NW~~ NW NW

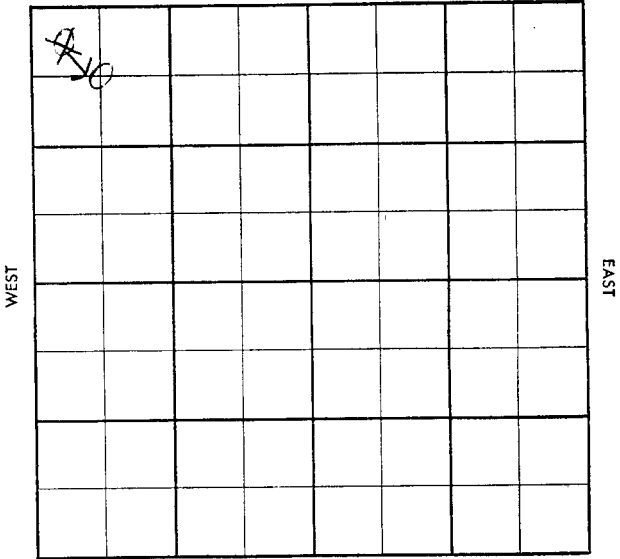

SOUTH

~~Twp. X~~ ~~Rge. X~~
~~Co. X~~ ~~Range 10~~

S-513-B

County Marion Elev. _____
 Sec. 1 Twp. 19 Rge. 1E
 Company John T. Hannah
 Form Name Lucille Wight No. 1

TOPS	DEPTH	LOG	DATUM
Anh.			
Tp.			
H.			
Tr.			
Dg.			
B.L.			
L.			
K.C.			
B.K.C.			
Ce.			
C.			
M.			
M.			
K.			
Mz.			
Mq.			
V.			
S.			
S.			
A.			
R.			
Pf.			
G.			
T.D.			

Loc. in Sec. _____
NW NW NW
SWW
 Geol. _____
 Contr. _____
Mid-West
 Pool _____
Beauty

0
 MAY 21 1958
FIRST REPORT

Date Comm. 5-13-58
8" @ 165 drlg. 2130

No. 1
 Sec. 1

CORRECTION

Pool
Co. Feet

S-513-B

County Marion Elev 1408 DF 1411 RR
 Sec. 1 Twp. 19 Rge. 4E
 Company John T. Hannah
 Farm Name Lucille Wight No. 1

TOPS	DEPTH	LOG	DATUM
Anh.			
Tp.			
H.			
Tr.			
D.			
B.L.			
L.			
K.C.	<u>1780</u>		
B.K.C.			
Co.			
C.			
M. <u>Chat</u>	<u>2310</u>		
M.			
K.	<u>2420</u>		
Mz.			
Mq.			
V.	<u>2670</u>		
S. <u>MZ sd</u>	<u>2772</u>		
S.			
A.	<u>2850</u>		
R.			
Pf.			
G.			
T.D.	<u>3050</u>		

Loc. in Sec. — NW NW NW
SW NW
CNW NW
 Geol. Kathol
 Contr. Mid-West
 Pool Beauty

0
JUN 18 58
ABANDONED

Date Comm. 5-13-58
8" @ 165 drlg. 2130 MAY 28 58

5" 2832 / 900 MIT JUN 3 58 JUN 11 58
JUN 16 58 DD 3051 TD (3)

SWD W

Co.
Lse.
No.
Sec.
T.
R.