


Marion

KANSAS

SECTION 10 TOWNSHIP 19 RANGE 3E

WELL NO. #1 Propp-Stenzel

COMPANY Chas. Carlock

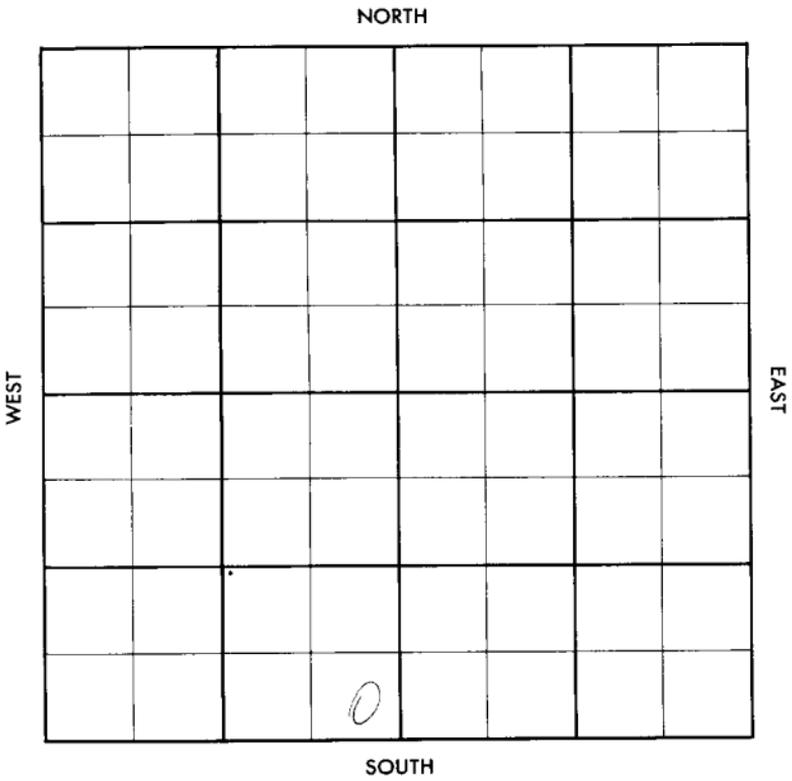

Marion

KANSAS

|            |            |          |
|------------|------------|----------|
| SEC.<br>10 | TWP.<br>19 | R.<br>3E |
|------------|------------|----------|

WELL NO. #1 Propp-Stenzel FARM

COMPANY Chas. Carlock

CONTRACTOR Bedell-Catt

WILDCAT


\_\_\_\_\_ Ft. from N. Line

\_\_\_\_\_ Ft. from S. Line

\_\_\_\_\_ Ft. from E. Line

\_\_\_\_\_ Ft. from W. Line

SE SE SW

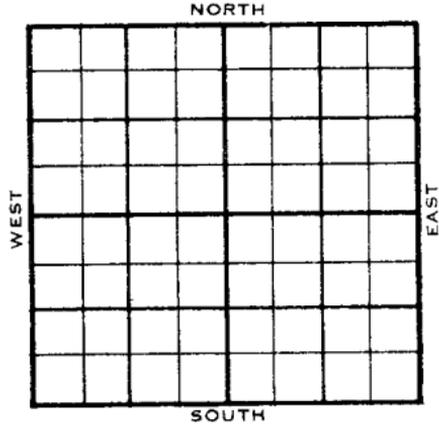

| 1956 | ELEVATION | REPORT |
|------|-----------|--------|
|      | 1394'     |        |

5-23 Comm. 5-21-56  
8" @ 100 w/85  
Drlg. 460

6-6 DST 2442-53 op 1 hr. rec. 115' OCMW,  
BHP 570/30"  
RTD 2883'  
No log.  
D & A  
L. 1882', KC. 1882', BKC 2250',  
M. 2442', K. 2584', sq. 2734',  
V. 2795', S. 2875',  
TD 2883'

**ABANDONED**

2794'  
2442'  
-----  
342



County Marion Elev. 1394  
 Sec. 10 Twp. 19 Rge. 3E  
 Company Chas. Carlock  
 Farm Name Propp-Stenzel No. 1

| TOPS   | DEPTH            | LOG | DATUM | Loc. in Sec.  |  |  |  |  |  |  |  |  |  |  |  |  |  |  |  |  |  |  |  |  |  |  |  |  |  |  |  |  |
|--------|------------------|-----|-------|---|--|--|--|--|--|--|--|--|--|--|--|--|--|--|--|--|--|--|--|--|--|--|--|--|--|--|--|--|
| Anh.   |                  |     |       | SE SE SW  |  |  |  |  |  |  |  |  |  |  |  |  |  |  |  |  |  |  |  |  |  |  |  |  |  |  |  |  |
| Tp.    |                  |     |       |   |  |  |  |  |  |  |  |  |  |  |  |  |  |  |  |  |  |  |  |  |  |  |  |  |  |  |  |  |
| H.     |                  |     |       |   |  |  |  |  |  |  |  |  |  |  |  |  |  |  |  |  |  |  |  |  |  |  |  |  |  |  |  |  |
| Tr.    |                  |     |       |   |  |  |  |  |  |  |  |  |  |  |  |  |  |  |  |  |  |  |  |  |  |  |  |  |  |  |  |  |
| Dg.    |                  |     |       |   |  |  |  |  |  |  |  |  |  |  |  |  |  |  |  |  |  |  |  |  |  |  |  |  |  |  |  |  |
| Bl.    |                  |     |       |   |  |  |  |  |  |  |  |  |  |  |  |  |  |  |  |  |  |  |  |  |  |  |  |  |  |  |  |  |
| L.     | <u>&gt; 1882</u> |     |       | Geol.   |  |  |  |  |  |  |  |  |  |  |  |  |  |  |  |  |  |  |  |  |  |  |  |  |  |  |  |  |
| K.C.   |                  |     |       | Contr.  |  |  |  |  |  |  |  |  |  |  |  |  |  |  |  |  |  |  |  |  |  |  |  |  |  |  |  |  |
| B.K.C. | <u>2250</u>      |     |       | Bedell-Catt   |  |  |  |  |  |  |  |  |  |  |  |  |  |  |  |  |  |  |  |  |  |  |  |  |  |  |  |  |
| Ce.    |                  |     |       |   |  |  |  |  |  |  |  |  |  |  |  |  |  |  |  |  |  |  |  |  |  |  |  |  |  |  |  |  |
| C.     |                  |     |       | Pool  |  |  |  |  |  |  |  |  |  |  |  |  |  |  |  |  |  |  |  |  |  |  |  |  |  |  |  |  |
| M.     | <u>2442</u>      |     |       | Wildcat   |  |  |  |  |  |  |  |  |  |  |  |  |  |  |  |  |  |  |  |  |  |  |  |  |  |  |  |  |
| N.     |                  |     |       |   |  |  |  |  |  |  |  |  |  |  |  |  |  |  |  |  |  |  |  |  |  |  |  |  |  |  |  |  |
| K.     | <u>2584</u>      |     |       | <table border="1"> <tr><td></td><td></td><td></td><td></td></tr> <tr><td></td><td></td><td></td><td></td></tr> <tr><td></td><td></td><td></td><td></td></tr> <tr><td></td><td></td><td></td><td></td></tr> <tr><td></td><td></td><td></td><td></td></tr> <tr><td></td><td></td><td></td><td></td></tr> <tr><td></td><td></td><td></td><td></td></tr> </table> |  |  |  |  |  |  |  |  |  |  |  |  |  |  |  |  |  |  |  |  |  |  |  |  |  |  |  |  |
|        |                  
|        |                  
| Nz.    |                  |     |       |   |  |  |  |  |  |  |  |  |  |  |  |  |  |  |  |  |  |  |  |  |  |  |  |  |  |  |  |  |
| Ma.    | <u>2784</u>      |     |       |   |  |  |  |  |  |  |  |  |  |  |  |  |  |  |  |  |  |  |  |  |  |  |  |  |  |  |  |  |
| V.     | <u>2795</u>      |     |       |   |  |  |  |  |  |  |  |  |  |  |  |  |  |  |  |  |  |  |  |  |  |  |  |  |  |  |  |  |
| S.     | <u>2825</u>      |     |       |   |  |  |  |  |  |  |  |  |  |  |  |  |  |  |  |  |  |  |  |  |  |  |  |  |  |  |  |  |
| S.     |                  |     |       |   |  |  |  |  |  |  |  |  |  |  |  |  |  |  |  |  |  |  |  |  |  |  |  |  |  |  |  |  |
| A.     |                  |     |       |   |  |  |  |  |  |  |  |  |  |  |  |  |  |  |  |  |  |  |  |  |  |  |  |  |  |  |  |  |
| R.     |                  |     |       |   |  |  |  |  |  |  |  |  |  |  |  |  |  |  |  |  |  |  |  |  |  |  |  |  |  |  |  |  |
| Pe.    |                  |     |       |   |  |  |  |  |  |  |  |  |  |  |  |  |  |  |  |  |  |  |  |  |  |  |  |  |  |  |  |  |
| G.     |                  |     |       |   |  |  |  |  |  |  |  |  |  |  |  |  |  |  |  |  |  |  |  |  |  |  |  |  |  |  |  |  |
| TD     | <u>2883</u>      |     |       |   |  |  |  |  |  |  |  |  |  |  |  |  |  |  |  |  |  |  |  |  |  |  |  |  |  |  |  |  |

Date Comm. 5-21-56 JUN 6 1956

8" @ 100/85 drl. 460 MAY 29 '56

DST 2442-53 1hr see 115' OCMW

BHP 570/30" @ 2570 JUN 6 '56

AP 2883 No Log

DIA

Co.  
No.  
Sec.  
T.  
R.