


Marion

KANSAS

SECTION 10 TOWNSHIP 19S RANGE 4E
WELL NO. #1 Bredemeir (*Bredemier*)
COMPANY ~~Mayfield & Smith~~ *Colon H. Jennings*
NORTH C $E\frac{1}{2}$ $E\frac{1}{2}$ NE

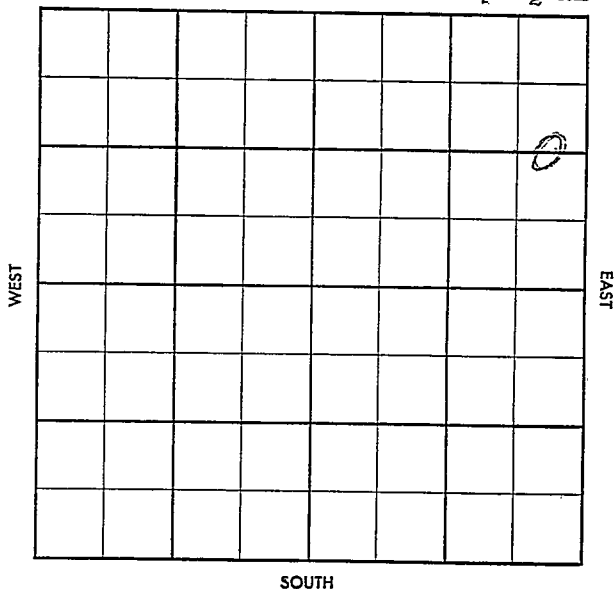


County Marion Elev. _____
 Sec. 10 Twp. 19 Rge. 1E
 Company Mayfield & Smith
 Farm Name Bredemeir No. 1

TOPS	DEPTH	LOG	DATUM
Anh.			
Tp.			
H.			
Tr.			
Dg.			
B.L.			
L.			
K.C.			
B.K.C.			
Ce.			
C. <u>chat</u>	<u>2292</u>		
M.			
M.			
K.			
Mz.			
Mq.			
V.			
S.			
S.			
A.			
R.			
Pf.			
G.			
T.D.	<u>2300</u>		

Loc. in Sec. C E $\frac{1}{2}$ E $\frac{1}{2}$ NE

Geol. _____
 Contr. Sunflower

Pool Beauty

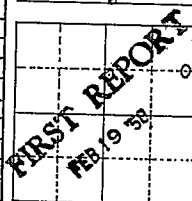

Date Comm. 8" @ 225 5" @ 2295

Co.

Lse.

No.

Sec.

T.

R.

CORRECTION

~~Top~~ ~~Pool~~
~~Dr~~ ~~Ford~~

S-513-B

County Marion Elev. 134.10 or 136 + 10
Sec. 10 Twp. 19 Rge. 1E
Company Mayfield & Smith John T. Jennings
Farm Name Bredemeir No. 1

TOPS	DEPTH	LOG	DATUM
Anh.			
Tp.			
H.			
Tr.			
Dg.			
B.L.			
L.			
K.C.	<u>2131</u>		
B.K.C.			
Ce.			
C.			
M. chat	<u>2292</u>		
M.			
K.			
Mz.			
Mq.			
V.			
S.			
S.			
A.			
R.			
Pf.			
G.			
T.D.	<u>2300</u>		

Loc. in Sec. C E¹ E¹ NE

Geol. Sunflower

Pool Beauty

APR 16 '58	

COMPLETE

Date Comm. 8th & 225 5th 2295 1st MAR 5 '58 NOCT

MAR 12 '58 MAR 19 '58 CO MAR 23 '58 DD 2325
fract APR 5 '58 \$ 3380 + W 8 hrs
top op APR 9 '58 APR 17 '58 P 61.7980
+ 300 BW 24 hrs P 58.4580
+ 300 BW 24 hrs

2580 ft + W