


Marion

KANSAS

SECTION 10 TOWNSHIP 19S RANGE 4E

WELL NO. #1 Klassen

COMPANY Harold Stith & John Hannah

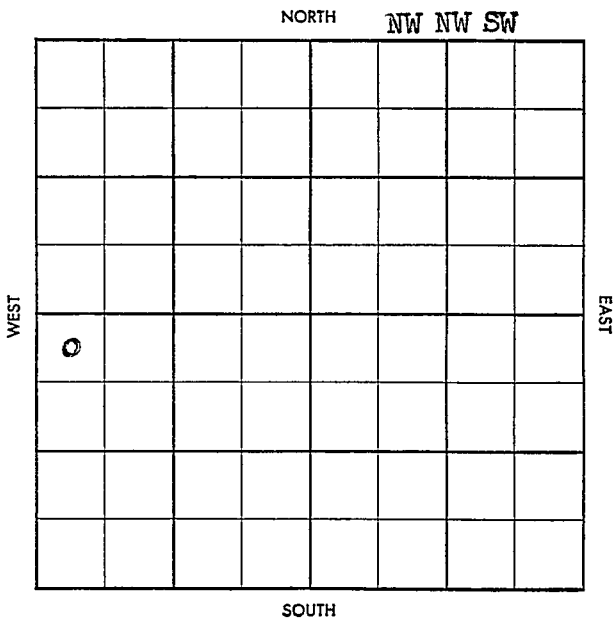

~~Twp. 12 N - R. 2 E~~  
~~Co. 5 E - Twp. 12 N~~

S-513-B

County Marion Elev. \_\_\_\_\_  
 Sec. 10 Twp. 19 Rge. 4E  
 Company Harold Stith & John Hannah  
 Farm Name Klassen No. 1

TOPS	DEPTH	LOG	DATUM
Anh.			
Tp.			
H.			
Tr.			
Dg.			
B.L.			
L.			
K.C.			
B.K.C.			
Ce.			
C.			
M.			
M.			
K.			
Mz.			
Mq.			
V.			
S.			
S.			
A.			
R.			
Pf.			
G.			
T.D.			

Loc. in Sec. \_\_\_\_\_  
NW NW SW  
 Geol. \_\_\_\_\_  
 Contr. \_\_\_\_\_  
Midwest #1  
 Pool \_\_\_\_\_  
Propp



Date Comm. \_\_\_\_\_  
rng. surf.  
 \_\_\_\_\_  
 \_\_\_\_\_  
 \_\_\_\_\_  
 \_\_\_\_\_  
 \_\_\_\_\_  
 \_\_\_\_\_  
 \_\_\_\_\_  
 \_\_\_\_\_  
 \_\_\_\_\_

Co.  
 Lse.  
 No.  
 Sec.  
 T.  
 R.

Twp. X Pct. X  
 Co. X Facet. X

5-513-B

County Marion Elev. 13470. 1550RB  
 Sec. 10 Twp. 19 Rge. LE  
 Company Harold Stith & John Hannah  
 Farm Name Klassen No. 1

TOPS	DEPTH	LOG	DATUM
Anh.			
Tp.			
H.			
Tr.			
Dg.			
B.L.			
L.			
K.C.			
B.K.C.			
Ce.			
C.			
M. <u>Chat</u>	<u>2297</u>		
M.			
K.			
Mz.			
Mq.			
V.			
S.			
S.			
A.			
R.			
Pf.			
G.			
T.D.	<u>2302</u>		

Loc. in Sec. NW NW SW  
 Geol. \_\_\_\_\_  
 Contr. Midwest #1  
 Pool \_\_\_\_\_  
 Propp \_\_\_\_\_

**COMPLETE**  
 6  
 JUL 30 '58

Date Comm. 6-17-58 8" 150  
 rng. surf. JUN 25 '58 5 1/2 2300 woc  
 JUL 2 '58 CO DD 2334 TD FU  
700' fld 8 hrs tstg  
 JUL 9 '58 DD 2336 40g to nitro A  
frac JUL 16 '58 pop JUL 23 '58 JUL 30 '58  
P 25 B 0 200 B w pd  
⊕

Co.  
 Sec.  
 No.  
 Sec.  
 T.  
 R.