


Marion

KANSAS

SECTION 10 TOWNSHIP 19S RANGE 4E

WELL NO. #1 Stenzel "C"

COMPANY Mayfield-Smith & Jennings

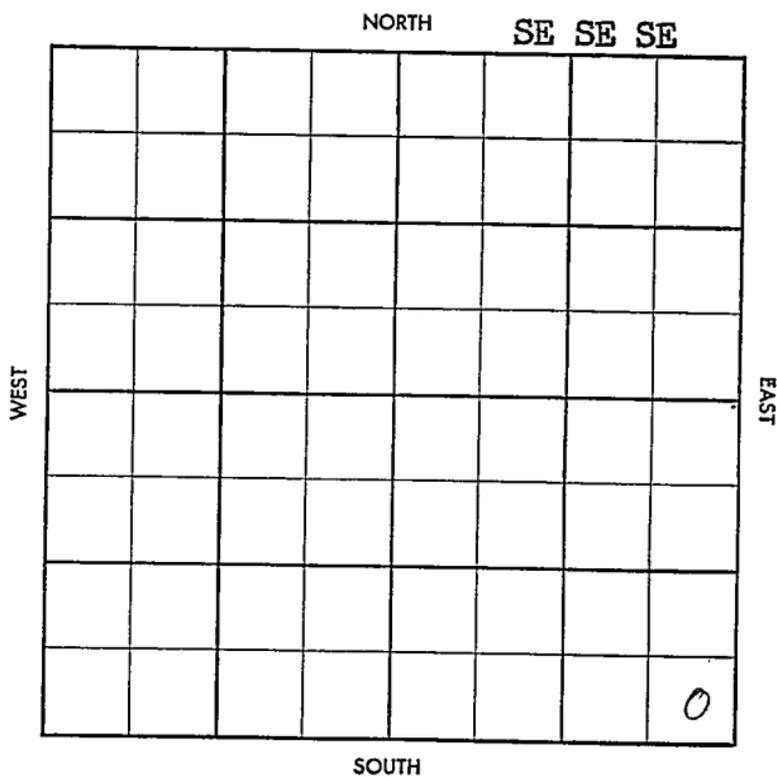

~~TWP. 10 N. R. 19 E. S. 34~~    ~~POOL~~  
~~CONTRACT~~    ~~FACIL.~~

S-513-B

County Marion Elev. 1357 DF  
 Sec. 10 Twp. 19 Rge. 4E  
 Company Mayfield-Smith & Jennings  
 Farm Name Stenzel "C" No. 1

TOPS	DEPTH	LOG	DATUM
Anh.			
Tp.			
H.			
Tr.			
Dg.			
B.L.			
L.			
K.C.			
B.K.C.			
Ce.			
C.			
M.			
M.			
K.			
Mz.			
Mq.			
V.			
S.			
S.			
A.			
R.			
Pf.			
G.			
T.D.			

Loc. in Sec. SE SE SE  
 Geol. \_\_\_\_\_  
 Contr. Sunflower  
 Pool \_\_\_\_\_  
Lost Springs

APR 2 1958  
**FIRST REPORT**

Date Comm. 3/28/58  
8" @ 175 w/150, Drlg. 2000

Co. \_\_\_\_\_  
 Sec. \_\_\_\_\_  
 No. \_\_\_\_\_  
 Sec. \_\_\_\_\_  
 T. \_\_\_\_\_  
 R. \_\_\_\_\_

Twp. X Foot X  
 Co. X Foot X

S-513-B

County Marion Elev. 1357 DF 1'60RB  
 Sec. 10 Twp. 19 Rge. 4E  
 Company Mayfield-Smith & Jennings  
 Farm Name Stenzel "C" No. 1

TOPS	DEPTH	LOG	DATUM
Anh.			
Tp.			
H.			
Tr.			
Dg.			
B.L.			
L.			
K.C.			
B.K.C.			
Ce.			
C.			
M.	<u>Chart 2270</u>		
M.			
K.			
Mz.			
Mq.			
V.			
S.			
S.			
A.			
R.			
Pf.			
G.			
T.D.	<u>2286</u>		

Loc. in Sec. SE SE SE  
 Geol. \_\_\_\_\_  
 Contr. Sunflower  
 Pool Lost Springs SE

**COMPLETE**  
 MAY 14 '58  
 D

Date Comm. 3/28/58  
8" @ 175 w/150, Drlg. 2000 5 1/2  
2281 WOC COOD 23187D  
APR 23 '58 30 gtm into co  
has \$66 pop MAY 14 '58  
P15 B0 125 BWPV  
¢

Co.  
 No.  
 Sec.  
 T.  
 R.