


Marion

KANSAS

SECTION 11 TOWNSHIP 19 RANGE 1 E

WELL NO. #1 Janzen

COMPANY E. K. Carey & A. Phillips

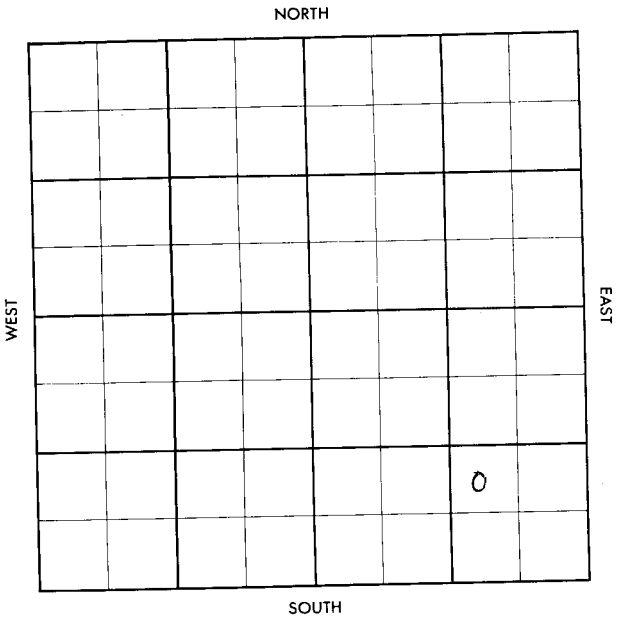

Marion

KANSAS

SEC. 11	TWP. 19	R. 1E
------------	------------	----------

WELL NO.

#1 Janzen

FARM

COMPANY

E.K.Carey & A. Phillips

CONTRACTOR

Co. Tools

WILDCAT


Ft. from N. Line

Ft. from S. Line

Ft. from E. Line

Ft. from W. Line

NW SE SE

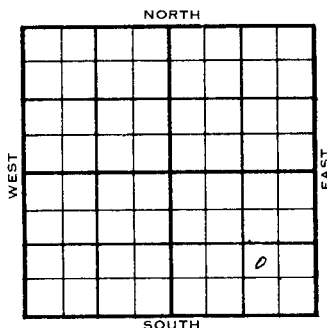

A-P DHM & FO

1955	ELEVATION 1450'	REPORT
11-30	Comm. 11-27-55 8" @ 140/85 WOC	
22-14	DST 2120-32 op 1 hr. rec. 20' mud, 740/20" DST 2696-2724 op 1 hr. rec. 24' mud, 385# 4½ mcf g dec. to 1 mcf at end of 1 hr. DST 2721-35 op 1 hr. rec. 30' socm, 180' sw, 792# DST 3115-60 op 1 hr. rec. 2' mud, 245# DST 3227-40 op 1 hr. rec. 300' sw, 1140/30" D & A KC 2114 M. 2704 V. 3155 S. 3234 TD 3243	

ABANDONED
ABANDONED

County **Marion** Elev. _____
 Sec. **11** Twp. **19** Rge. **1E**
 Company **E. K. Carey & A. Phillips**
 Farm Name **Janzen** No. **1**

TOPS	DEPTH	LOG	DATUM	Loc. in Sec.
Anh.				NW SE SE
Tp.				
H.				
Tr.				
Dg.				
Bl.				
L.				Geol. _____
K.C.				Contr. _____
B.K.C.				Co. tools
Ce.				
C.				Pool
M.				Wildcat
M.				
K.				
Mz.				
Me.				
V.				
S.				
S.				
A.				
R.				
Pe.				
G.				
TD.				

FIRST REPORT
 NOV 20 '55

Date Comm. **11-27-55**
8th @ 1140/85 WOC

A-P DHM & FO

County Marion Elev. 1450
 Sec. 11 Twp. 19 Rge. 1E
 Company E. K. Carey & A. Phillips
 Farm Name Janzen No. 1

TOPS	DEPTH	LOG	DATUM	Loc. in Sec.
Anh.				NW SE SE
Tr.				
H.				
Tr.				
Dg.				
BL.				
L.				
K.C.	<u>2114</u>		<u>664</u>	Geol.
B.K.C.				Contr.
Ce.				Co. tools
C.				Pool
M.	<u>2704</u>		<u>1254</u>	Wildcat
M.				
K.				
Mz.				
Mo.				
V.	<u>3155</u>		<u>1705</u>	ABANDONED
S.	<u>3234</u>		<u>1784</u>	
S.				
A.				
R.				
Pe.				
G.				
T.D.	<u>3243</u>			

Date Comm. 11-27-55 DEC 14 1955

8" @ 140/75 DST 2120-32 open 1 hr.

rec. 20' mud 740/20" DST 2696-2724

open 1 hr. rec. 24' mud 385#

4½ mcf g dec. to 1 mcf at end of 1 hr.

DST 2721-35 open 1 hr. rec. 30' socm

180' sw 792# DST 3115-60 open 1 hr.

rec. 2' mud 245# DST 3227-40 open

1 hr. rec. 300' sw 1140/30"

D & A