

O.W.W.O.

FORM 51 25M 8-50 WESTERN Marion

KANSAS

Section 11 Township 19 Range 4E

Well No. #1 Boettcher

Company Geo. Martin Jennings, Mayfield & Smith

NORTH SW SW SE

| | | | | | | | |
|--|--|--|--|--|--|--|--|
| | | | | | | | |
| | | | | | | | |
WEST

EAST

SOUTH

0

Sec. 11 Twp. 19 R. 4 E

Well No. # 1 Boettcher Farm

Geo. Martin Company

Contractor

Wildcat

Ft. from N. Line

330


Ft. from S. Line

Ft. from E. Line

330

Ft. from W. Line

SW SW SE

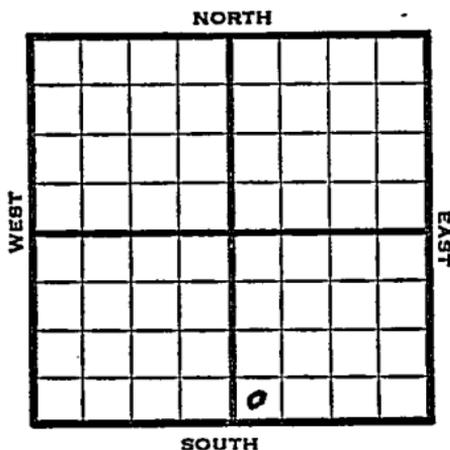

1952

Elev. 1376 REPORT

8/6

Spud 8-5-52
8" @ 105 WOC

8/20

Spud 8-5-52
D&A TD 2666
8" @ 105 Lans. 1752
KC 2091 Miss 2285
Kh 2395 Chat 2589
Misener 2611 Viola 2634
TD 2666 D&A

ABANDONED


County Marion State Kansas

Sec. 11 (Blk.) 19 (Sur.) 4E Map No.

Operator Geo Martin

Well No. 1 Farm Boettcher

Elev. _____ Location SW SW SE

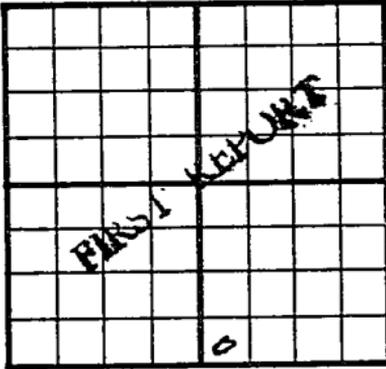

330 Ft. From S Line SE

330 Ft. From W Line Quarter

Ist. Report AUG 6 1952

Completion _____

Remarks _____

Spudding Date 8-5-52

Drlg. Data Wildcat

8" @ 105 WCC

J. G. McGEHEE

