


Marion

KANSAS

SECTION 11 TOWNSHIP 19S RANGE 4E

WELL NO. #1 Boettcher

COMPANY Mayfield & Smith

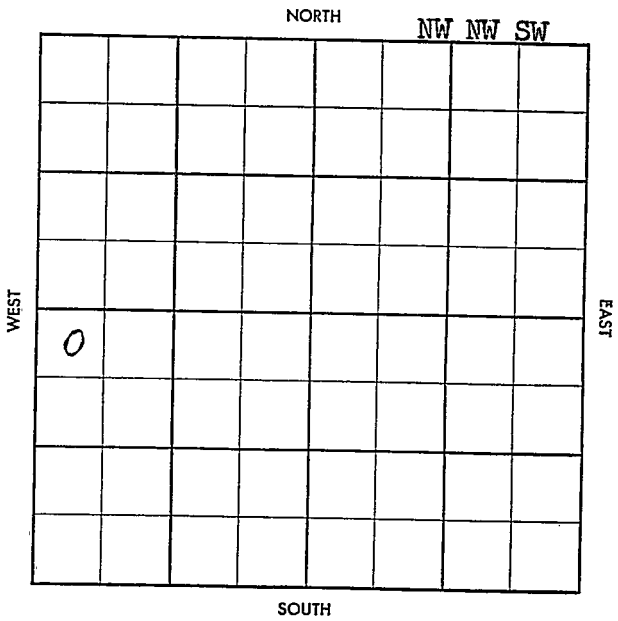


Twp. ~~XXXXXX~~ Pool ~~XXXXXX~~
Co. ~~XXXXXX~~ Facet ~~XXXXXX~~

S-513-B

County Marion Elev. 1369 DF
Sec. 11 Twp. 19 Rge. 4E
Company Mayfield & Smith
Farm Name Boettcher No. 1

TOPS	DEPTH	LOG	DATUM
Anh.			
Tp.			
H.			
Tr.			
Dg.			
B.L.			
L.			
K.C.			
B.K.C.			
Ce.			
C.			
M.	2296		
M.			
K.			
Mz.			
Mq.			
V.			
S.			
S.			
A.			
R.			
Pf.			
G.			
T.D.			

Loc. in Sec. NW NW SW
Geol.
Contr. Sunflower
Pool Lost Springs SE

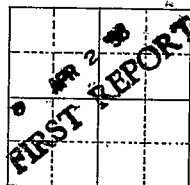

Date Comm. 2/17/58
8" @ 230, TD 2306, 5" @ 2299 MICT

Co.

Use

No.

Sec.

T.

R.

Twp. 4 Pool. 1

Co. Facet

S-513-B

County Marion Elev. 1369 DF 1372.8
 Sec. 11 Twp. 19 Rge. 4E
 Company Mayfield & Smith
 Farm Name Boettcher No. 1

TOPS	DEPTH	LOG	DATUM
Anh.			
Tp.			
H.			
Tr.			
Dg.			
B.L.			
L.			
K.C.			
B.K.C.			
Ce.			
C.			
M.	2296		
M.	2354 1/2		
K.			
Mz.			
Mq.			
V.			
S.			
S.			
A.			
R.			
Pf.			
G.			
T.D.			

Loc. in Sec. NW NW SW

Geol. Sunflower

Contr. Sunflower

Pool Lost Springs SE

COMPLETE

MAY 14 '58

Date Comm. 2/17/58

8" @ 230, TD 2306, 5" @ 2299 MICT APR 9 '58

CO PD 23 5 1/2 PB 23 4 8

45 gals nitro CO APR 16 '58 Frac

APR 23 '58 \$ 1530 + 200 BW 8403

pop APR 30 '58 MAY 7 '58 MAY 14 '58 P 1530

pd 125 BW pd

\$