

Marion


KANSAS

SECTION 11 TOWNSHIP 19S RANGE 4E

WELL NO. #3 Boettcher

COMPANY Ernst Development Co.

NORTH *C-11/3*
~~SE~~ NW

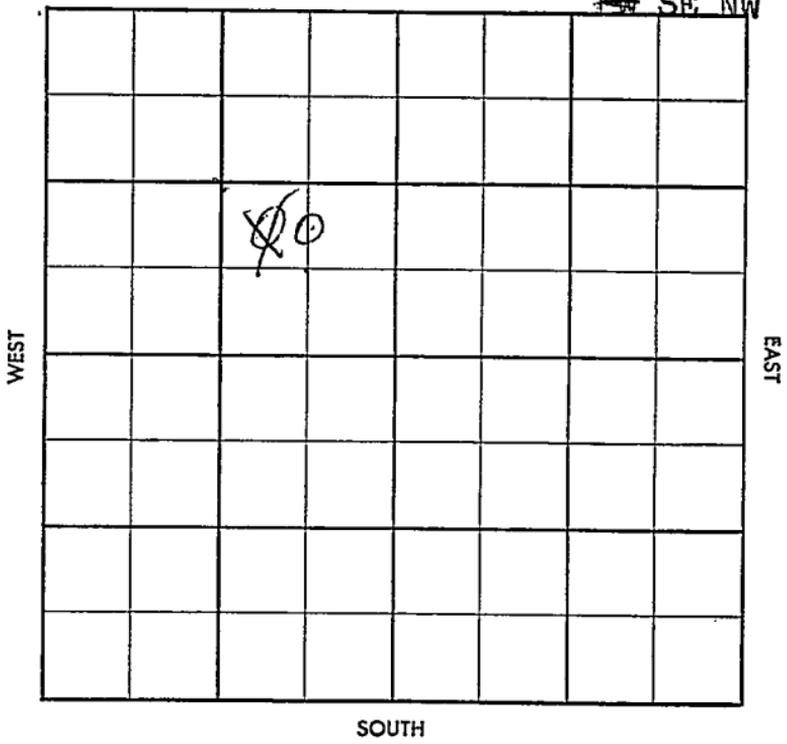

CO. ~~Marion~~ ELEV. _____

SECT ~~11~~ TWP. 19 RGE. ~~4E~~

COMPANY ~~Ernst Development~~ Co. 3

FIRST REPORT
JAN 2 '58

FARM Boettcher

LOC. NW SE NW

GEOL. _____

CONTR. Sunflower Drlg. #2

POOL Beauty

SPUD 12/24/57

8" @ 225, Drlg. 2058.

CO.

USE.

NO.

SEC.

TWP.

RGE.

