


Section 11 Township 19 Range 4 E

Well No. # 1 Boettcher

Company Derby Drlg.

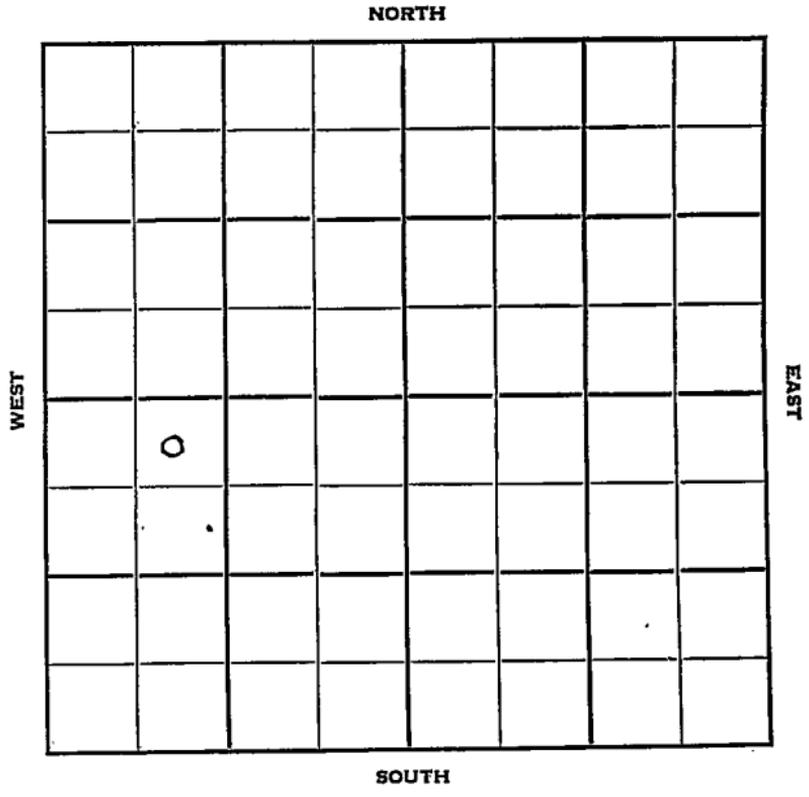

Sec. 11 Twp. 19 R. 4 E ✓

Well No. # 1 Boettcher Farm

Derby Drlg. Company

Slusser Drlg. Contractor

Wildcat


330 Ft. from N. Line

\_\_\_\_\_ Ft. from S. Line

\_\_\_\_\_ Ft. from E. Line

990 Ft. from W. Line

NE NW SW

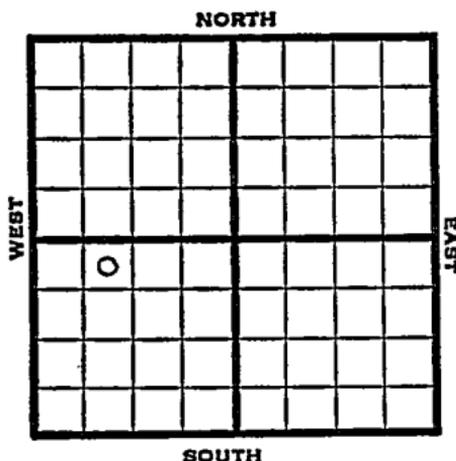

1951

Elev. 1378' REPORT

4/18

Location

5/23

Spud 4-28-51

D&A TD 2370

8" @ 153

KC 1753 Miss 2296

DST 2296-2303 opn 1 hr Rec. 10' mud

DST 2296-2350 opn 1½ hr Rec. 210' ocm

1320' gas 6" @ 2302 TD 2370

FU 500' wtr D&A

**ABANDONED**


County Marion State Kansas

Sec. 11 (Blk. 19) (Sur. 4E) (Twp.) (Rge.) Map No.

Operator Derby Drlg.

Well No. 1 Farm Boettcher

Elev. \_\_\_\_\_ Location NE NW SW

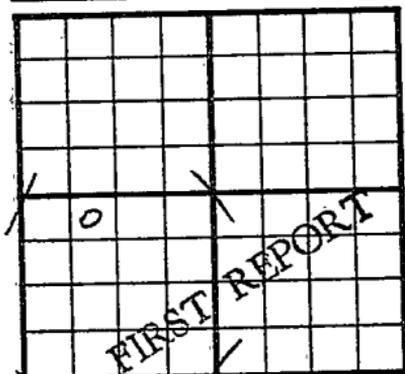

330 Ft. From N Line SW

990 Ft. From W Line Quarter

Ist. Report APR 18 1951

Completion \_\_\_\_\_

Remarks \_\_\_\_\_

Slusser Drlg. - Contr.

Spudding Date \_\_\_\_\_

Drlg. Data Wildcat

Location


County Marion State Kansas

Sec. 11 (Blk. 19) (Sur. 4E) Map No.

Operator Derby Drlg.

Well No. 1 Farm Boettcher

Elev. 1378 Location NE NW SW

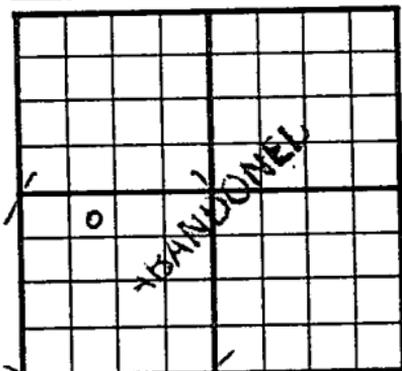

330 Ft. From N Line SW

990 Ft. From W Line Quarter

1st. Report

Completion MAY 23 1951

Remarks Wildcat

Slusser Drlg. - Contr.

Spudding Date 4-28-51

Drlg. Data D & A TD 2370

8" @ 153 KC 1753 Miss. 2296

DST 2296-2303 open 1 hr. Rec. 10' mud

DST 2296-2350 open 1½ hr. Rec. 210' ocm

1320' gas 6" @ 2302 TD 2370 FU 500' wat

D & A