

Marion

KANSAS


SECTION 11 TOWNSHIP 19S RANGE 4E

WELL NO. #1 Boettcher

COMPANY J. P. Jennings

NORTH

*n/2 NW*  
SW NE NW

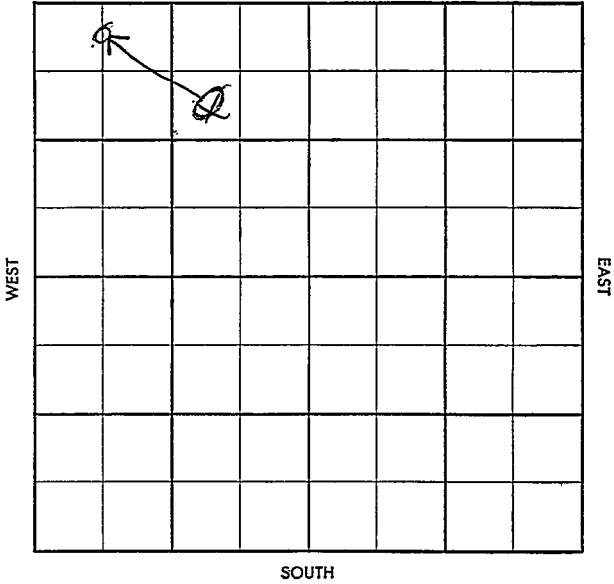

S-513-B

~~TOP~~ ~~POOL~~  
~~SW~~ ~~NE~~

County Marion Elev. \_\_\_\_\_  
Sec. 11 Twp. 19 Rge. 4E  
Company J. P. Jennings  
Farm Name Boettcher No. 1

TOPS	DEPTH	LOG	DATUM
Anh.			
Tp.			
H.			
Tr.			
Dg.			
B.L.			
L.			
K.C.			
B.K.C.			
Ce.			
C.			
M.			
M.			
K.			
Mz.			
Mq.			
V.			
S.			
S.			
A.			
R.			
Pf.			
G.			
T.D.			

Loc. in Sec. SW NE NW  
Geol. \_\_\_\_\_  
Contr. Midwest  
Pool Boettcher

**FIRST REPORT**  
MAY 28 58

Date Comm. 5-25-58  
8" @ 160 WOC

Co.  
Lse.  
No.  
Sec.  
T.  
R.

# CORRELATION

Twp. ~~X~~ Pool. ~~X~~  
Co. ~~X~~ Facet. ~~X~~

S-513-B

County: Marion Elev. 1387 DF  
 Sec. 11 Twp. 19 Rge. 4E  
 Company: J. P. Jennings & J. P. Jennings Ernest Develop  
 Farm Name: Boettcher No. 73

TOPS	DEPTH	LOG	DATUM
Anh.			
Tp.			
H.			
Tr.			
Dg.			
B.L.			
L.			
K.C.	1790		
B.K.C.			
Ce.			
C.			
M.	2300		
M.			
K.			
Mz.			
Mq.			
V.			
S.			
S.			
A.			
R.			
Pf.			
G.			
T.D.	2309		

Loc. in Sec. SW NW NW  
N 1/2 NW  
 Geol. \_\_\_\_\_  
 Contr. \_\_\_\_\_  
Midwest  
 Pool Beauty  
Boettcher

o	
COMPLETE	
JUL 2 '58	

Date Comm. 5-25-58  
8" @ 160 WOC JUN 3 '58 5 1/2" 2304  
no log woc JUN 11 '58 JUN 18 '58 CO  
DP ~~2334~~ 2334 TD shot  
Proc Pop P 25 BOPD  
775W JUN 25 '58 JUL 2 '58

J

No. Sec. T. R.