

NORTH

WEST

EAST

SOUTH

Location.....

Drilling Remarks

Rig Up.....

Drilling Remarks

RECORD

Cased.....in.....ft.

Sand.....

Gas.....

Oil_____

Total Depth.....

PRODUCTION

1st 24 hrs. Nat.....

1st 24 hrs. after shot.....

Gas.....cu. ft.....

Dry Hole.....

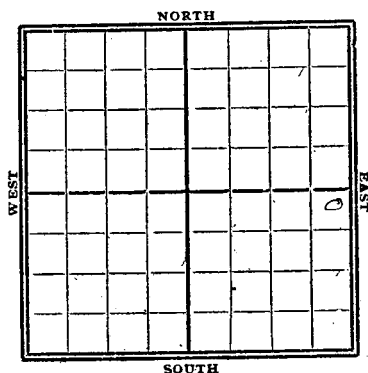
Abandoned.....

Map No. **KANSAS** Sec. **12** Twp. **19** R. **2^E**Well No. **1-Nickel** Farm**Darby Oil** Company**244** Ft. from N. Line

Ft. from S. Line

264 Ft. from E. Line

Ft. from W. Line

**1928**

Date

REPORT

0/24	Rig Bldg.
0/31	Spud 250'
11/17	Drily 670'
11/14	" 1000'
11/21	" 1415'
11/28	" 1865'
12/5	" 1995'
12/12	" 2175'
12/19	Top chat 2441' 2437'
	Drily 2447 show gas
12/26	Top chat 2437 SLM (con)
	2 M gas at 2448'
1929	
1/2	SD 2448' - T.D.
1/9	
1/16	
1/23	sho oil & HFW - 2474 - 79
	drily 2535'
1/30	UIR 8" - 2546' - T.D.
2/6	Base line 2586'
	S.D. 2747' - T.D.
	(over)

2/9 Top Viola 2814 - 32'
2100' oil - No water

2/13 - Top Viola level 2814
T.D. 2830'

pump 445 bbls oil
Sump.

2/20 - Swab 412 bbls

1/15 395 bbls oil

Blairton

K 24
MAP NO. 10013 SEC. 12 TWP. 19 R. 2EWELL NO. 1 NickelHardy Oil COMPANY

CONTRACTOR

SECTION PLAT

			0

244 FT. FROM N. LINE

_____ FT. FROM S. LINE

264 FT. FROM E. LINE

_____ FT. FROM W. LINE

FIRST REPORTS

LOCATION _____

RIG UP _____

DRILLING AND REMARKS:

Rig Switching

RECORD

CASED _____ IN., _____ FT.

SAND _____

GAS _____

OIL _____

TOTAL DEPTH _____

PRODUCTION

1ST 24 HRS. NAT. _____

1ST 24 HRS. AFTER SHOT _____

GAS _____ CU. FT.

DRY HOLE _____

ABANDONED _____

DATE

OCT 24 1928

192

S. J. LEWIS

SCOUT

MAP NO. KANSAS SEC. 12 TWP. 19 R. 2E
 WELL NO. 1124
Nickel

Darby Oil COMPANY
 _____ CONTRACTOR

SECTION PLAT

			C

244 FT. FROM N. LINE
 _____ FT. FROM S. LINE
264 FT. FROM E. LINE
 _____ FT. FROM W. LINE

COMPLETED

LOCATION _____

RIG UP _____

DRILLING AND REMARKS:

Top Viola Line
2814 Total Depth
2830

Pumping 445 lbs.

RECORD

CASED _____ IN. _____ FT.
 SAND _____
 GAS _____
 OIL _____
 TOTAL DEPTH 2830

PRODUCTION

1ST 24 HRS. NAT. _____
 1ST 24 HRS. AFTER SHOT _____
 GAS _____ CU. FT.
 DRY HOLE _____
 ABANDONED _____

DATE

11-18-1929

S. J. LEWIS

192

SCOUT