

Map No. KANSAS Sec. 12 Twp. 19 R. 2 E

Well No. 4 - Nickel Farm

Darby Pet Company

NORTH

WEST

EAST

						0	

SOUTH

Location.....

Drilling Remarks

Rig Up.....

Drilling Remarks

RECORD

Cased.....in.....ft.

Sand.....

Gas.....

Oil.....

Total Depth.....

PRODUCTION

1st 24 hrs. Nat.....

1st 24 hrs. after shot.....


Gas.....cu. ft.....

Dry Hole.....

Abandoned.....

Map No. KANSAS Sec. 12 Twp. 19 R. 2 E.
 Well No. 4 - Nickel Farm _____
Darby Pet Company _____

990 Ft. from N. Line
 _____ Ft. from S. Line
990 Ft. from E. Line
 _____ Ft. from W. Line

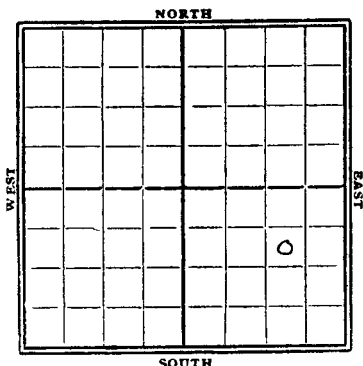

1929

Date	REPORT
5/15	Bldy Rcy
5/22	Rising up
6/29	Orly 525'
7/15	" 1165'
7/12	" 1590'
6/19	" 1760'
6/26	" 1890'
7/2	" 1890'
7/10	Top Chat 2475'
	show gas 2482-90'
	show oil 2490'
	SD. 2495'-HFW
7/17	Orly 2570'
7/24	Viola 2831-52'
	swab 24 bbl 14 hr.
	kill shoot
7/31	sand 2831-52'
	T.D. 2852'
	shot 60 gts
	85 bbl oil
	Somp

24 KANSAS

Map No. _____ Sec. 12 Twp. 19 R. 2 E

Well No. 4 Nickel

Darby Jet Co Company

Contractor

FIRST REPORTS

SECTION PLAT

990 Ft. from N. Line

_____ Ft. from S. Line

990 Ft. from E. Line

_____ Ft. from W. Line

			0

Location _____

Rig up _____

Drilling and Remarks: _____

RECORD

Cased _____ in., _____ ft.

Sand _____

Gas _____

Oil _____

Total Depth _____

PRODUCTION

1st 24 hrs. Nat. _____

1st 24 hrs. after shot _____

Gas _____ Cu. Ft.

Dry Hole _____

Abandoned _____

Date

MAY 15 1929

192

CHAS. L. SHERWOOD

Scout

Marion
 K24 **KANSAS** Sec. *12* Twp. *19* R. *2*
 Well No. *4 Nickel*
Darby put Company _____ Contractor _____

COMPLETE**SECTION PLAT**

			o

990 Ft. from N. Line

_____ Ft. from S. Line

990 Ft. from E. Line

_____ Ft. from W. Line

Location _____

Rig up _____

Drilling and Remarks:

*60/85 Bls.***RECORD**

Cased _____ in., _____ ft.

Sand *2831-52*

Gas _____

Oil _____

Total Depth *2852***PRODUCTION**

1st 24 hrs. Nat. _____

1st 24 hrs. after shot _____

Gas _____ Cu. Ft.

Dry Hole _____

Abandoned _____

Date
JUL 31 1929**CHAS. L SHERWOOD**