

KANSAS


Marion

Form 51-5M-7-39-Palace

Section **12** Township **19** Range **2E**

Well No. **#4 Rempel** (Rempel)

Company **Aladdin Petroleum**

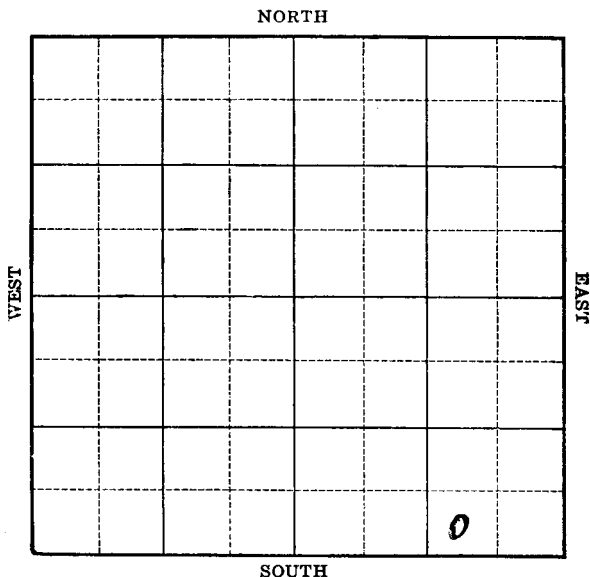

Sec. 12 Twp. 19 R. 2-E

Well No. "4 Remple Farm

Madain Petr. Company


Misc.)

\_\_\_\_\_ Ft. from N. Line

550 Ft. from S. Line

990 Ft. from E. Line

\_\_\_\_\_ Ft. from W. Line

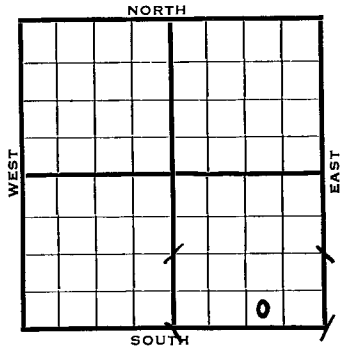

1940	REPORT
7/2	Location
7/11	"
7/18	Derrick.
7/25	12" - 160' Drlg. 1210'
8/2	Chst. 2469' Drlg. 2562'
8/8	Viola 2851' 5" - 2851'
	T.D. 2857' 400' oil 12 hours.
8/14	T.D. 2859 2000 acid.
8/21	Viola 2851'
	5" - 2851'
	T.D. 2859'
	2000 acid.
	Pump 50 oil & 50 water.
	COMPLETED

Map No. 24 Sec. 12 Twp. 19 R. 2E

Well No. 4 Remple

Aladdin Petroleum Company

Contractor

**FIRST REPORT**

SW SE SE

       Ft. from N. Line

330 Ft. from S. Line

990 Ft. from E. Line

       Ft. from W. Line

MISCELLANEOUS

**SECTION PLAT**

			0

Location X

Rig up       

Drilling and Remarks:

**RECORD**

Cased        in.,        ft.

Sand       

Gas       

Oil       

Total Depth       

**PRODUCTION**

1st 24 hrs. Nat.       

1st 24 hrs. after shot       

Gas        Cu. Ft.

Dry Hole       

Abandoned       

Date

JUL 2 1940 19

S. J. LEWIS

Scout

Map No. 24 Sec. 12 Twp. 19 R. 2E

Well No. 4 Remple

Aladdin Petroleum Company

Contractor

COMPLETED

SW SE SE

\_\_\_\_\_ Ft. from N. Line

350 Ft. from S. Line

990 Ft. from E. Line

\_\_\_\_\_ Ft. from W. Line

SECTION PLAT

			0

MISCELLANEOUS

Location \_\_\_\_\_

Rig up \_\_\_\_\_

Drilling and Remarks:

*115/2 2851*

*5" @ 2851*

*2000 acid*

*Pump 50 oil*

*50 Na Feb.*

RECORD

Cased \_\_\_\_\_ in., \_\_\_\_\_ ft.

Sand \_\_\_\_\_

Gas \_\_\_\_\_

Oil \_\_\_\_\_

Total Depth 2859

PRODUCTION

1st 24 hrs. Nat. \_\_\_\_\_

1st 24 hrs. after shot \_\_\_\_\_

Gas \_\_\_\_\_ Cu. Ft.

Dry Hole \_\_\_\_\_

Abandoned \_\_\_\_\_

Date

AUG 21 1940 19

S. J. LEWIS Scout