

Map No. KANSAS Sec. 12 Twp. 19 R. 2E


Well No. 2-Rampel Farm Madlin Pet Corp company

NORTH

(Rampel)

WEST

EAST

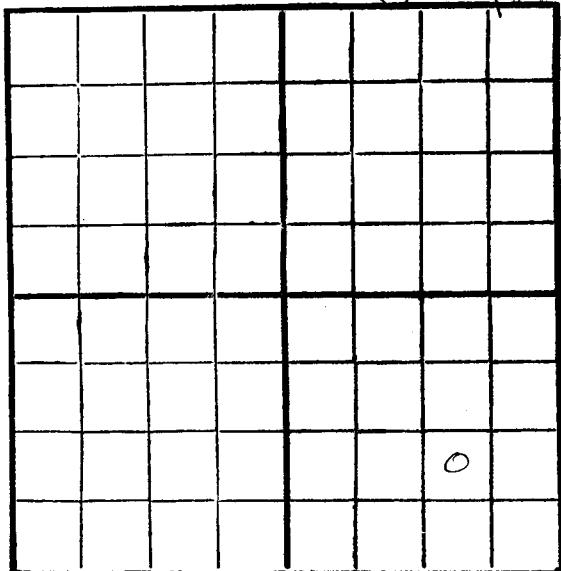

SOUTH

Location _____

Drilling Remarks

Rig Up _____

Drilling Remarks

RECORD

Cased _____ in. _____ ft.

Sand _____

Gas _____

Oil _____

Total Depth _____

PRODUCTION

1st 24 hrs. Nat. _____

1st 24 hrs. after shot _____


Gas _____ cu. ft. _____

Dry Hole _____

Abandoned _____

Map No. KANSAS Sec. 12 Twp. 19 R. 2E
Well No. 2- Rampel Farm
Aladdin Petr Company

 Ft. from N. Line
990 Ft. from S. Line
990 Ft. from E. Line
 Ft. from W. Line

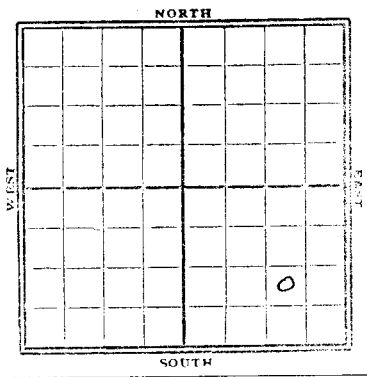

1929

Date	REPORT
9/18	Location
9/25	Log
10/2	Log
10/19	Log
10/16	Log 1150'
10/23	" 1610'
10/30	" 1900'
11/6	Log 2035'
11/13	Log 8" - 2420'
11/20	set 8" - 2465'
11/27	VIR 6" - 2525'
12/4	Chat 2478-90'
	show gas 2485'
	HFW at 2520'
	Base line 2600' drly.
12/11	Log 2836-45'
	shot 20 qt - Clog out
	800' fluid in hole
12/23	sand 2836-45'
	T.D. 2845'
	shot 20 qt
	60 bbl oil

Marion

2-1 KANSAS
 Map No. _____ Sec. 12 Twp. 19 R. 2 E
 Well No. 2 Rampel
 Aladdin Petroleum Co. _____ Company
 _____ Contractor

FIRST REPORTS

SECTION PLAT

_____ Ft. from N. Line

990 Ft. from S. Line

990 Ft. from E. Line

_____ Ft. from W. Line

			0

Location _____ ✓

Rig up _____

Drilling and Remarks:

Formerly Shell
 Petroleum

RECORD

Cased _____ in., _____ ft.

Sand _____

Gas _____

Oil _____

Total Depth _____

PRODUCTION

1st 24 hrs. Nat. _____

1st 24 hrs. after shot _____

Gas _____ Cu. Ft.

Dry Hole _____

Abandoned _____

Date

SEP 18 1929

CHAS. L. SHERWOOD

192

Scout

Marion

24 KANSAS Map No. Sec. 12 Twp. 19 R. 2 E

Well No. 2 Rampel

Aladdin Prod Co. Company

Contractor

COMPLETE

Ft. from N. Line

990 Ft. from S. Line

990 Ft. from E. Line

Ft. from W. Line

SECTION PLAT

			0

Location

Rig up

Drilling and Remarks:

20/60 Bls.

RECORD

Cased in., ft.

Sand 2836-2845

Gas

Oil

Total Depth 2845

PRODUCTION

1st 24 hrs. Nat.

1st 24 hrs. after shot

Gas Cu. Ft.

Dry Hole

Abandoned

Date

DEC 18 1929

192

CHAS. L. SHERWOOD

Scout