

Well No. 2 - Suderman Farm

Empire O & K Company

WEST

EAST

SOUTH

Location.....

Drilling Remarks

Rig Up.....

Drilling Remarks

RECORD

Cased.....in.....ft.

Sand.....

Gas.....

Oil.....

Total Depth.....

PRODUCTION

1st 24 hrs. Nat.....

1st 24 hrs. after shot.....

Gas..... cu. ft.....

Dry Hole.....

Abandoned.....


Map No. KANSAS Sec. 12 Twp. 19 R. 2 E
2
Well No. Suderman Farm
Empire O & R Company

_____ Ft. from N. Line

990 Ft. from S. Line

330 Ft. from E. Line

_____ Ft. from W. Line

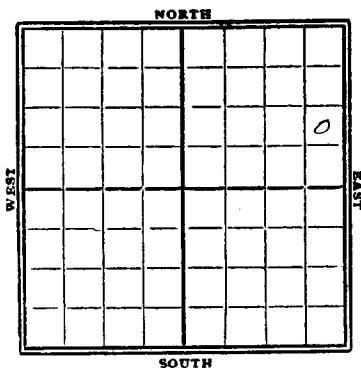

1929

Date

REPORT

1/29	Co S.
2/16	Bldg Rg
2/13	Rig
2/20	
2/27	Rgn up
3/16	
3/13	Spdy
3/20	Drilg 975'
3/27	" 1350'
4/3	" 2045'
4/10	top chat 2436 $\frac{1}{2}$ 17 gas show oil 2465-75
4/17	hole full water 1419 2500 Drilg 2580' 8"-2542'
4/24	Viola 2823-61'
	shot 20 gts - est 25 bbl
5/1	fsq csq TD 2861'
5/8	Viola time 2823-61'
	TD. 2861'
	shot 20 & 135 gts
	swab 25 bbl oil
	Pomp.

*Marion*MAP NO. KANSAS SEC. 12 TWP. 19 R. 2EH24WELL NO. 2 BuckermanEmpire Oil & Ref. COMPANY

CONTRACTOR

SECTION PLAT

			0

____ FT. FROM N. LINE

990 FT. FROM S. LINE330 FT. FROM E. LINE

____ FT. FROM W. LINE

FIRST REPORTS

LOCATION _____

RIG UP _____

DRILLING AND REMARKS:

ROY

RECORD

CASED _____ IN. _____ FT.

SAND _____

GAS _____

OIL _____

TOTAL DEPTH _____

PRODUCTION

1ST 24 HRS. NAT. _____

1ST 24 HRS. AFTER SHOT _____

GAS _____ CU. FT.

DRY HOLE _____

ABANDONED _____

DATE

JAN 30 1929192SCOUT

Map No. KANSAS Sec. 12 Twp. 19 R. 2E

Well No. 24 2 Suckerman

Empire Oil & Ref. Company
Contractor

SECTION PLAT

.....Ft. from N. Line

990 Ft. from S. Line

330 Ft. from E. Line

.....Ft. from W. Line

			0

Location.....

Rig up.....

Drilling and Remarks:

Viola line
2823-61
Shut 20 and
1359 to.

swathed 2588

RECORD

Cased.....in.,ft.

Sand.....

Gas.....

Oil.....

Total Depth 2861

PRODUCTION

1st 24 hrs. Nat.....

1st 24 hrs. after shot.....

Gas.....Cu. Ft.

Dry Hole.....

Abandoned.....

Date

MAY 8 1928 CHAS. L. SHESHOOL
192 Scout