


Marion

KANSAS

SECTION 14 TOWNSHIP 19S RANGE 3E

WELL NO. #1 Vogel

COMPANY Augusta Oil

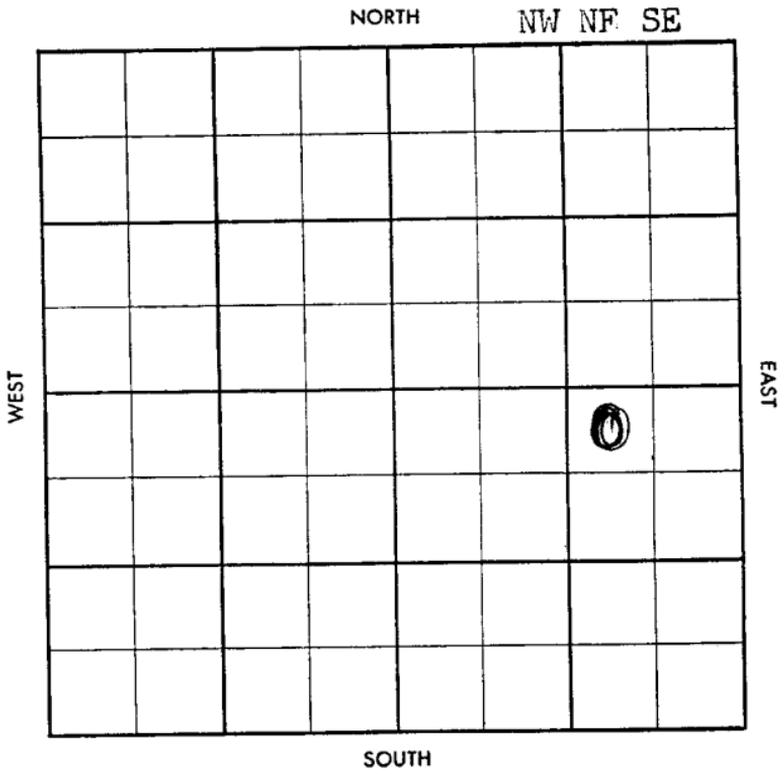

WILDCAT

S-513-B

10

County Marion Elev. 1392
 Sec. 14 Twp. 19 Rge. 3E
 Company Augusta Oil 19A
 Farm Name Vogel No. 1

TOPS	DEPTH	LOG	DATUM
Anh.			
Tp.			
H.			
Tr.			
Dg.			
B.L.			
L.			
K.C.	1888		
B.K.C.			
Ce.			
C.			
M.	2385		
M.			
K.			
Mz.			
Mq.			
V.	2733		
S.			
S.			
A.			
R.			
Pf.			
G.			
T.D.	2761		

Loc. in Sec. _____
NW NE SE

 Geol. _____
 Contr. _____
Co. tools
 Pool _____
Wildcat

JUN 22 58
**FIRST REPORT
 ABANDONED**

Date Comm. 1-10-58
8" @ 150 DST 2733-61 open 1 hr.
rec. 35' mud 865#
D & A

2385
 1392
 993