


Marion

KANSAS

SECTION 14 TOWNSHIP 19S RANGE 4E

WELL NO. #1 Hutchens

COMPANY Santa Fe Oil Co., Inc.

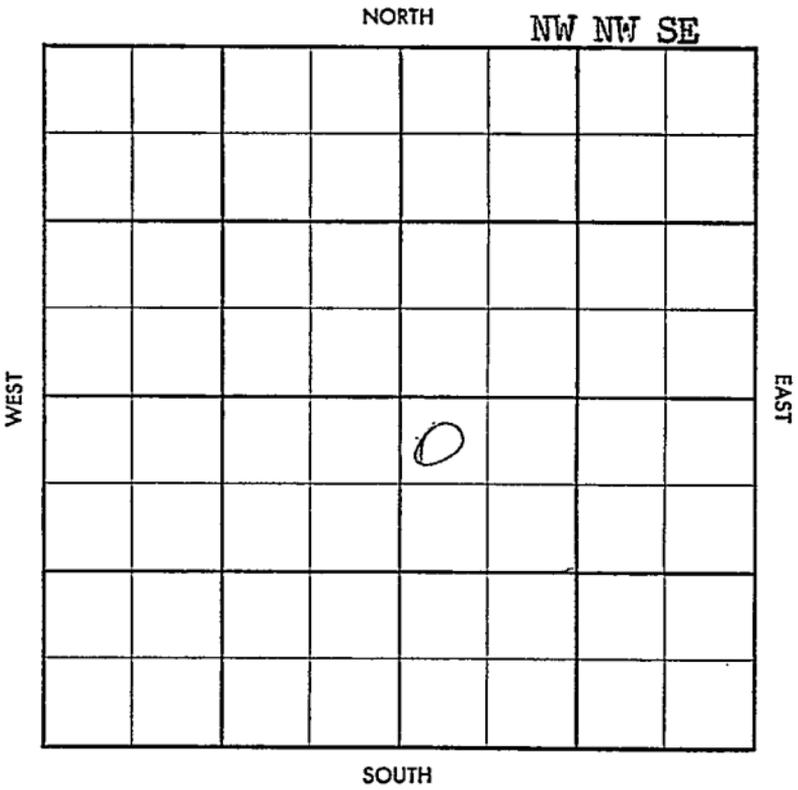

~~Marion~~
~~14~~

County Marion Elev. _____
 Sec. 14 Twp. 19 Rge. 4E
 Company Santa Fe Oil Co., Inc.
 Farm Name Hutchens No. 1

TOPS	DEPTH	LOG	DATUM
Anh.			
Tp.			
H.			
Tr.			
Dg.			
B.L.			
L.			
K.C.			
B.K.C.			
Ce.			
C.			
M.			
M.			
K.			
Mz.			
Mq.			
V.			
S.			
S.			
A.			
R.			
Pf.			
G.			
T.D.			

Loc. in Sec. _____
NW NW SE
 Geol. _____
 Contr. _____
Lewis Drlg.
 Pool _____
Quarry Siding

APR 16 1938
FIRST REPORT

Date Comm. _____
Location

Co.
 Sec.
 No.
 Sec.
 T.
 R.

Twp. X Pool X
 Co. X Facet X

S-513-B

County Marion Elev. 1974.00 1932.89
 Sec. 14 Twp. 19 Rge. 1E
 Company Santa Fe Oil Co., Inc.
 Farm Name Hutchens No. 1

TOPS	DEPTH	LOG	DATUM
Anh.			
Tp.			
H.			
Tr.			
Dg.			
B.L.			
L.			
K.C.			
B.K.C.			
Ce.			
C.			
M. <u>Chart 2276</u>			
M.			
K.			
Mz.			
Mq.			
V.			
S.			
S.			
A.			
R.			
Pf.			
G.			
T.D.	<u>2292</u>		

Loc. in Sec. NW NW SE
 Geol. _____
 Contr. Lewis Drlg.
 Pool Quarry Siding

COMPLETE			
○			
JUL 30 '58			

Date Comm. 5-1-58 8" 215
 Location APR 23 '58 APR 30 '58 M1
5" 2282 wocT MAY 14 '58 MAY 21 '58 MAY 28 '58
JUN 3 '58 JUN 11 '58 JUN 18 '58 JUN 25 '58 JUL 2 '58 Codd
2301 F10 25B FPH 30% oil
A frac pop JUL 9 '58 JUL 16 '58
JUL 23 '58 JUL 30 '58 P 43B0 43BW
pd

Co.
Lse.
No.
Sec.
T.
R.