

Marion


KANSAS

SECTION 14 TOWNSHIP 19 RANGE 4E

WELL NO. #1 Theis

COMPANY Slusser Drlg. Co.

NORTH NE SW SW

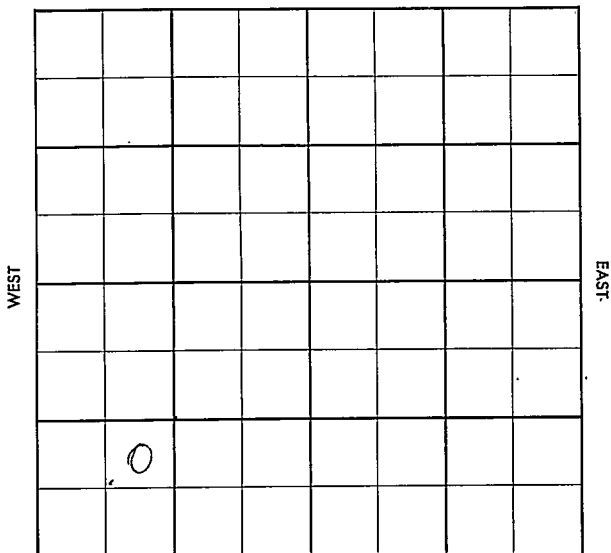

SOUTH

# WILDCAT

FORM 513 SUNRAY

County Mazon Elev. \_\_\_\_\_  
Sec. 14 Twp. 19 Rgs. 4E  
Company Slusser Drlg. Co.  
Farm Name Theis No. 1

TOPS	DEPTH	LOG	DATUM	Loc. in Sec.
Anh.				NE SW SW
Tr.				
H.				
Tr.				
Dg.				
Bl.				
L.				Geol. _____
K.C.				Contr. _____
B.K.C.				Co. Tools _____
Ce.				Pool _____
C.				Wildcat
M.				
M.				
K.				
Mz.				
Ma.				
V.				
S.				
S.				
A.				
R.				
PE.				
G.				
T.D.				

FIRST REPORT  
MAR 13 '57

Date Comm. 3-10-57  
8" @ 182/150, Drlg. 1331

~~10~~

Co.

Lse.

No.

Sec.

T.

R.

# 19A-N

FORM 513 SUNRAY

County Madison Elev. 1401  
 Sec. 14 Twp. 19 Rge. 4E  
 Company Slusser Drlg. Co.  
 FarmName Theis No. 1

TOPS	DEPTH	LOG	DATUM
Anh.			
Ip.			
H.			
Tr.			
Dg.			
Bl.			
L.			
K.C.			
B.K.C.			
Ce.			
C.	2308		
M.			
M.	2324		
K.			
Mz.			
Mo.			
V.			
S.			
S.			
A.			
R.			
PE.			
G.			
TD.	2324		

Loc. in Sec. NE SW SW  
 Geol. \_\_\_\_\_  
 Contr. \_\_\_\_\_  
 Co. Tools \_\_\_\_\_  
 Pool Wildcat  
 COMPLETE  
 JUN 5 '57

Date Comm. 3-10-57  
 8" @ 182/150, Drlg. 1331 5 1/2 2324  
 WOC T APR 24 '57 MAY 1 '57 MICT CO.  
CO DD 2362 TD (SOS)  
Frac & Ld. (Flowing <sup>new</sup> oil?)  
MAY 15 '57 POT. MAY 22 '57 MAY 29 '57 JUN 5 '57 P.  
10 Bopd + 10 Bwpd est  
grav 37°