


Map No. KANSAS Sec. 15 Twp. 19 R. 14^E

Well No. 1- Jasper Farm
R. E. Smith et al Company

_____ Ft. from N. Line
250 Ft. from S. Line
_____ Ft. from E. Line
250 Ft. from W. Line

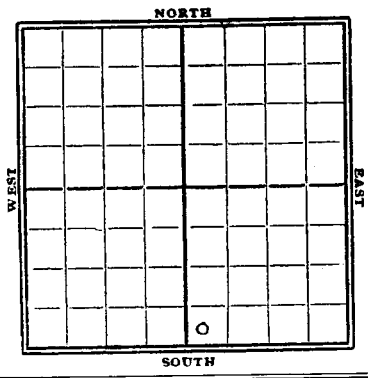

1929

Date	REPORT
<u>2/20</u>	<u>Location</u>
<u>2/27</u>	<u>---</u>
<u>3/6</u>	<u>---</u>
<u>3/13</u>	<u>---</u>
<u>3/20</u>	<u>---</u>
<u>3/27</u>	<u>---</u>
<u>4/3</u>	<u>Machine</u>
<u>4/10</u>	<u>---</u>
<u>4/17</u>	<u>---</u>
<u>4/24</u>	<u>---</u>
<u>5/11</u>	<u>Only 410'</u>
<u>5/18</u>	<u>" 1557'</u>
<u>5/15</u>	<u>HFW 1587-1612'</u> <u>only 1761'</u>
<u>5/29</u>	<u>HFW 1587-1612'</u> <u>TD 1791'</u> <u>Cr. & Abandon.</u>

Cooper

Map No. **KANSAS** Sec. **15** Twp. **19** R. **14** ^E

Well No. *20114*
Gasper
R. E. Smith et al Company

Contractor

FIRST REPORTS

SECTION PLAT

..... Ft. from N. Line
250 Ft. from S. Line
 Ft. from E. Line
250 Ft. from W. Line

		6	

Location
 Rig up.....
 Drilling and Remarks:

RECORD

Cased.....in.,ft.
 Sand.....
 Gas.....
 Oil.....
 Total Depth.....

PRODUCTION

1st 24 hrs. Nat.....
 1st 24 hrs. after shot.....
 Gas.....Cu. Ft.
 Dry Hole.....
 Abandoned.....

Date

FEB 20 1929

CHAS. L. SHERWOOD

.....192..... Scout

KANSAS

Coffee

Map No. _____ Sec. 15 Twp. 19 R. 14

Well No. 1 *Gasper*

R. E. Smith

Company

Contractor

COMPLETE

SECTION PLAT

		0	

_____ Ft. from N. Line

750 Ft. from S. Line

_____ Ft. from E. Line

750 Ft. from W. Line

ABANDONED

Location _____

Rig up _____

Drilling and Remarks:

NFW 1587-1612

RECORD

Cased _____ in., _____ ft.

Sand _____

Gas _____

Oil _____

Total Depth 1791

PRODUCTION

1st 24 hrs. Nat. _____

1st 24 hrs. after shot _____

Gas _____ Cu. Ft.

Dry Hole

Abandoned

Date

MAY 29 1929

192. **CHAS. L. SHERWOOD**

Scout